


STATE OF KANSAS
STATE CORPORATION COMMISSION

Give All Information Completely
Make Required Affidavit
Mail or Deliver Report to:
Conservation Division
State Corporation Commission
800 Bittling Building
Wichita, Kansas

WELL PLUGGING RECORD

15-077-01073-00-00

NORTH

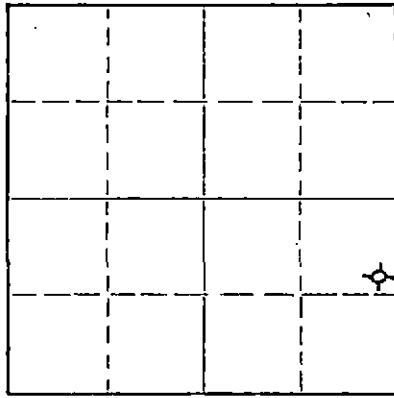

Locate well correctly on above
Section Plat

Harper County, Sec. 36 Twp. 31 Rge. 9 (E) W (W)
Location as "NE/CNW/SW" or footage from lines SE NE SE
Lease Owner O. H. Parker
Lease Name Warren Well No. 1
Office Address P. O. Drawer 791 - Ponca City, Oklahoma
Character of Well (completed as Oil, Gas or Dry Hole) Dry Hole
Date well completed 5/11/55 19
Application for plugging filed 5/11/55 19
Application for plugging approved 5/11/55 19
Plugging commenced 5/11/55 19
Plugging completed 5/11/55 19
Reason for abandonment of well or producing formation Dry Hole

If a producing well is abandoned, date of last production 19
Was permission obtained from the Conservation Division or its agents before plugging was commenced? Yes

Name of Conservation Agent who supervised plugging of this well Ruel Durkee
Producing formation Depth to top Bottom Total Depth of Well 4405 Feet
Show depth and thickness of all water, oil and gas formations.

OIL, GAS OR WATER RECORDS

CASING RECORD

FORMATION	CONTENT	FROM	TO	SIZE	PUT IN	PULLED OUT
Heebner	dry		3371	8 5/8	285'	
Douglas	dry		3508			
Mississippi	salt water		4380			

Describe in detail the manner in which the well was plugged, indicating where the mud fluid was placed and the method or methods used in introducing it into the hole. If cement or other plugs were used, state the character of same and depth placed, from feet to feet for each plug set.

Filled hole with heavy drilling mud from Total Depth to 250'. Set plug and cemented with 20 sacks cement.
Filled hole with extra heavy drilling mud from 250' 59 35'. Set plug and cemented with 10 sacks of cement.

RECEIVED
STATE CORPORATION COMMISSION
MAY 16 1955
05-16-55
CONSERVATION DIVISION
Wichita, Kansas

(If additional description is necessary, use BACK of this sheet)

Name of Plugging Contractor Prime Drilling Company
Address 1005 Central Building - Wichita, Kansas

STATE OF Kansas, COUNTY OF Sedgwick, ss.
L. J. Clappitt (signature of owner) or (signature of operator) of the above-described well, being first duly sworn on oath, says: That I have knowledge of the facts, statements, and matters herein contained and the log of the above-described well as filed and that the same are true and correct. So help me God.

(Signature) [Signature]
1005 Central Building - Wichita, Ks.
(Address)

SUBSCRIBED AND SWORN TO before me this 13th day of May, 1955

[Signature] Notary Public.

My commission expires November 22, 1958

PLUGGING
MAY 26 31 9W
118 24

ROTARY DRILLING LOG

15-077-01073-0008

OPERATOR: O. H. Parker
 Warren #1
 SE NE SE Sec. 36-31-9W
 Harper County, Kansas

CONTRACTOR: Prime Drilling Company
 COMM: 4/27/55
 COMP: 5/11/55

<u>Formation</u>	
Surface Clay	30
Red Bed	285
Red Bed & Shale	1075
Shale & Shells	1320
Anhydrite	1350
Lime & Shale	1190
Lime & Shale Streaks	1835
Lime & Shale	3330
Sandy Lime & Shale	3410
Lime & Shale	3450
Shale, Sand & Lime Strks	3585
Lime & Shale	3715
Lime	4248
Lime & Shale	4370
Lime	4386
Chat & Lime	4405
Rotary Total Depth	4405

Remarks
 Set 8-5/8" surface casing at 284'
 cemented with 200 sacks common cement
 and 2% C.C.

TOPS
 Mississippi 4381'

Dry and Abandoned

We certify that the above log is true
 and correct to the best of our
 knowledge and belief.

PRIME DRILLING COMPANY

BY: R.R. Mc Nicol

4381
 1522
 2859

RECEIVED
 STATE CORPORATION COMMISSIONER
 MAY 16 1955
 CONSERVATION DIVISION
 Wichita, Kansas

PLUGGING
 REC 36-31-9W
 DATE 11-8-54