


STATE OF KANSAS
STATE CORPORATION COMMISSION

Give All Information Completely
Make Required Affidavit
Mail or Deliver Report to:
Conservation Division
State Corporation Commission
212 No. Market
Wichita, Kansas, 67202

NORTH

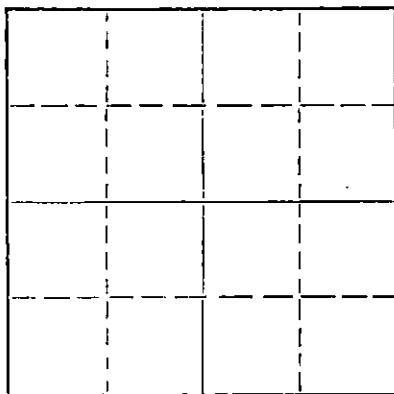

Locate well correctly on above
Section Plat

WELL PLUGGING RECORD

15-007-26136-0000

County. Sec 20 Twp. 31 Rge. 10 (E) W (W)
Location as "NE/CNW/SW" or footage from lines C NW SW
Lease Owner Kathol Petroleum, Inc.
Lease Name Rucker Well No. 1
Office Address 900 Sutton Place, Wichita, Kansas
Character of Well (completed as Oil, Gas or Dry Hole) Dry
Date well completed 12/24 19 69
Application for plugging filed 2/2 19 70
Application for plugging approved 2/4 19 70
Plugging commenced 2/13 19 70
Plugging completed 2/17 19 70
Reason for abandonment of well or producing formation Oil formation not
productive
If a producing well is abandoned, date of last production 19
Was permission obtained from the Conservation Division or its agents before plugging was com-
menced? YES

Name of Conservation Agent who supervised plugging of this well G. Russell Biberstein
Producing formation _____ Depth to top _____ Bottom _____ Total Depth of Well 4594 Feet
Show depth and thickness of all water, oil and gas formations.

OIL, GAS OR WATER RECORDS

CASING RECORD

FORMATION	CONTENT	FROM	TO	SIZE	PUT IN	PULLED OUT
				8 5/8	240	None
				5 1/2	4591	2620
RECEIVED STATE CORPORATION COMMISSION FEB 24 1970 CONSERVATION DIVISION Wichita, Kansas						

Describe in detail the manner in which the well was plugged, indicating where the mud fluid was placed and the method or methods used
in introducing it into the hole. If cement or other plugs were used, state the character of same and depth placed, from _____ feet to
_____ feet for each plug set.

Pump Plug to 4340' and Pump
75 sacks cement on plug

Bail Hole to 240' Set 10' Rock
Bridge to 230' Dump 3 1/2 yds.
Ready mix concrete to surface

(If additional description is necessary, use BACK of this sheet)
Name of Plugging Contractor Ralph Comstock Pipe Puller, Inc.
Address 320 N. Park Stafford, Kansas

STATE OF Kansas, COUNTY OF Sedgwick, ss.
Homer J. Catt (employee of owner) or (owner or operator) of the above-described
well, being first duly sworn on oath, says: That I have knowledge of the facts, statements, and matters herein contained and the log of the
above-described well as filed and that the same are true and correct. So help me God.

(Signature) Homer J. Catt
205 Main St. Augusta Kansas
(Address)

SUBSCRIBED AND SWORN to before me this 20th day of February 19 70

My commission expires 3-22-71

Betty M. Maloney Notary Public.

15-007-20136-0000

DRILLERS LOG

#1 RUCKER

CASING RECORD:	OPERATOR: Kathol Petroleum, Inc.	DESCRIPTION:
8 5/8" @ 240' w/ 190 sacks cem.	CONTRACTOR: Kathol Petroleum, Inc.	C. NW SW
5 1/2" @ 4591' w/ 75 sacks cem.	COMMENCED: December 12, 1969	Sec. 20-31S-10W
	COMPLETED: December 24, 1969	Barber Co., Kansas
		ELEVATION:
T.D. 4594' (Log)	I.P. Dry and Abandoned	1768' K.B.

<u>FORMATION:</u>	<u>FROM</u>	<u>TO</u>	<u>REMARKS</u>
surface hole	0	245	
red bed & shale	245	645	
shale & lime	645	1745	
lime & shale	1745	2245	
shale & lime	2245	3150	
lime & shale	3150	3650	
shale	3650	3785	
shale & lime	3785	3901	
lime & shale	3901	4015	
lime	4015	4399	
lime & shale	4399	4513	
shale & lime	4513	4544	
chert	4544	4562	
cherty lime	4562	4592 R.T.D.	

RECEIVED
STATE CORPORATION COMMISSION
FEB 4 1970
CONSERVATION DIVISION
Wichita, Kansas

I hereby certify that the above information is true and correct to the best of my knowledge.

KATHOL PETROLEUM, INC.

Don D. Shawver
Don D. Shawver

Subscribed and sworn to before me this 2nd day of February, 1970.

Betty M. Maloney
Betty M. Maloney, Notary Public

My Commission Expires:

3/22/71