


STATE OF KANSAS
STATE CORPORATION COMMISSION

WELL PLUGGING RECORD 15-007-20486-00-00

Give All Information Completely
Make Required Affidavit
Mail or Deliver Report to
Conservation Division
State Corporation Comm.
245 North Water
Wichita, KS 67202

Barber County. Sec. 20 Twp. 31S Rge. 10W E/W
Location as "NE/CNW/SW" or footage from lines

1650 FNL 610 FWL
Lease Owner Texas Oil & Gas Corp.
Lease Name Rucker Well No. 1
Office Address Suite 300-200 W. Douglas, Wichita, Kansas 67202
Character of Well (Completed as Oil, Gas or Dry Hole) Gas

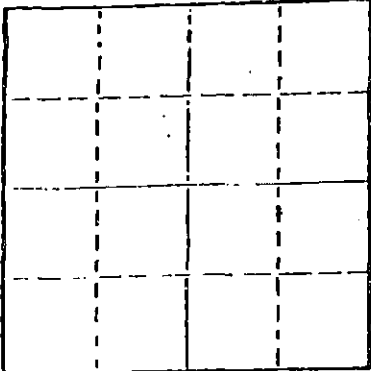

Locate well correctly on above Section Plat

Date Well completed 5-28 19 77
Application for plugging filed 1-24 19 80
Application for plugging approved 1-26 19 80
Plugging commenced 2-6 19 80
Plugging completed 2-18 19 80
Reason for abandonment of well or producing formation Not productive

If a producing well is abandoned, date of last production 19

Was permission obtained from the Conservation Division or its agents before plugging was commenced? Yes

Name of Conservation Agent who supervised plugging of this well Bill Owens
Producing formation Depth to top Bottom Total Depth of Well 4574
Show depth and thickness of all water, oil and gas formations.

OIL, GAS OR WATER RECORDS

CASING RECORD

FORMATION	CONTENT	FROM	TO	SIZE	PUT IN	PULLED OUT
				8 5/8	257	None
				4 1/2	4568	3780

Describe in detail the manner in which the well was plugged, indicating where the mud fluid was placed and the method or methods used in introducing it into the hold. If cement or other plugs were used, state the character of same and depth placed, from feet to feet for each plug set.

CIBP at 4535
Sand from 4535 to 4489
4 sacks cement from 4489 to 4450

Ripped pipe at 3780

Pump in 5 hulls 20 - sacks Jell

100 sacks 50-50 POZ 4% Jell 3% Cal.

(If additional description is necessary, use BACK of this sheet)

Name of Plugging Contractor Clarke Corporation


STATE OF Kansas COUNTY OF Barber, ss.
Elmo Morgenstern (employee of owner) or (owner or operator)
of the above-described well, being first duly sworn on oath, says: That I have knowledge of the facts, statements, and matters herein contained and the log of the above-described well as filed and that the same are true and correct. So help me God.

(Signature) Elmo Morgenstern
Medicine Lodge, Kansas
(Address)

SUBSCRIBED AND SWORN TO before me this 19th day of February, 1980

Jessie Hamilton
Notary Public.

My commission expires April 4, 1982

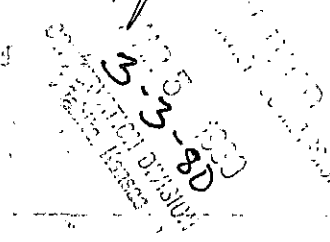


15-007-20486-000

RUCER #1

Location: 1650' FNL + 610' FWL Sec 20-315-10W BARBER Co ILS

ELEVATION: 1731 A.L. 1739 K.B.

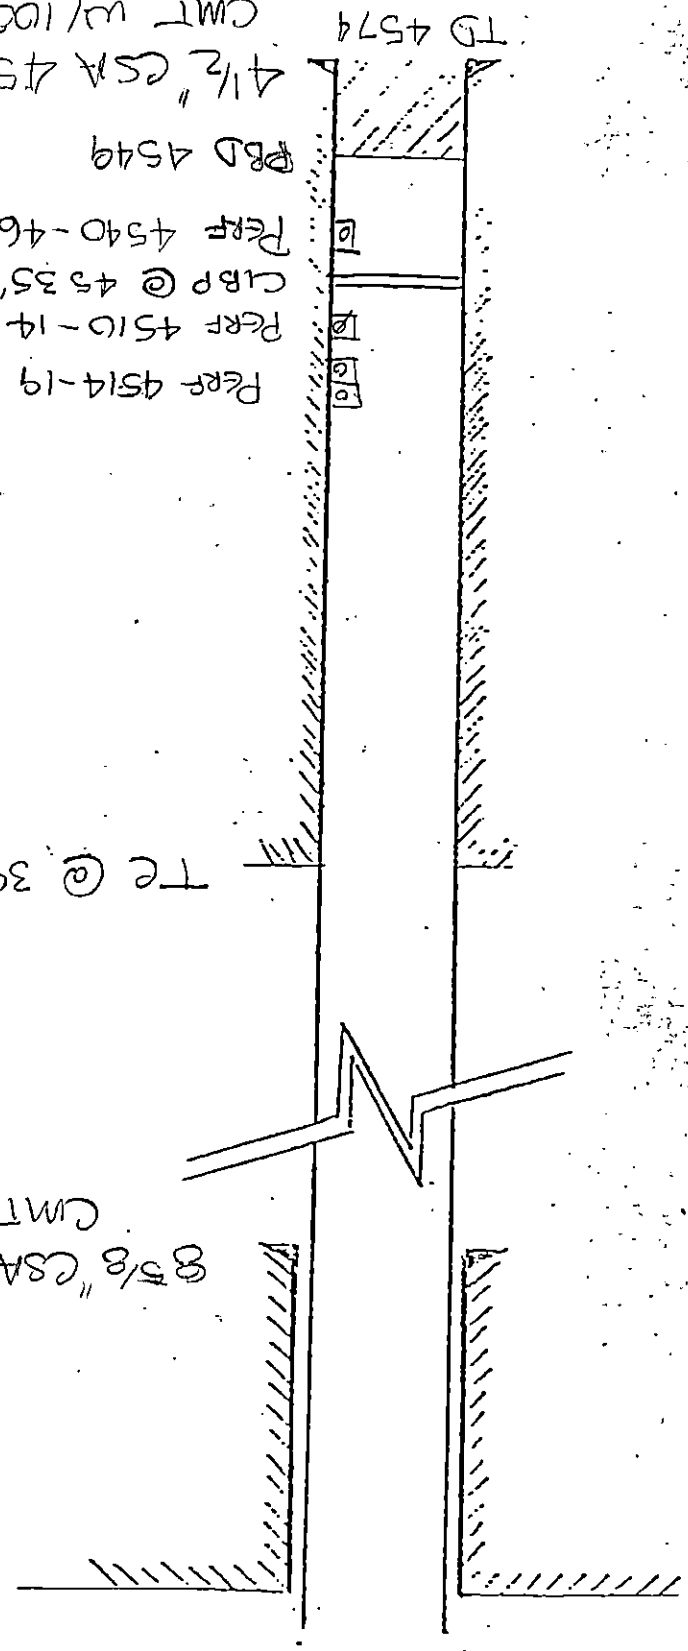

8 5/8" CSA 257'
CMT w/250 SX

TC @ 3950

PERF 4514-19

PERF 4510-14, 4525-27

CIRP @ 4535'

PERF 4540-46

PBD 4549

4 1/2" CSA 4568
CMT w/100 SX

RECEIVED
STATE CORPORATION COMMISSION
JAN 25 1980
CONSERVATION DIVISION
Wichita, Kansas

