


15-191-01519-00-00

STATE OF KANSAS
STATE CORPORATION COMMISSION

WELL PLUGGING RECORD

Give All Information Completely
Make Required Affidavit
Mail or Deliver Report to:
Conservation Division
State Corporation Commission
800 Bittling Building
Wichita, Kansas

Sumner County. Sec. 5 Twp. 34S Rge. 4 (E) 4 (W)
Location as "NE/CNW/SW" or footage from lines C- SE SW NW
Lease Owner Sunray Mid-Continent Oil Company
Lease Name Netahla Well No. 2
Office Address Box 195, Great Bend, Kansas
Character of Well (completed as Oil, Gas or Dry Hole) Dry Hole
Date well completed September 2 19 55
Application for plugging filed September 2 19 55
Application for plugging approved September 6 19 55
Plugging commenced September 2 19 55
Plugging completed September 2 19 55
Reason for abandonment of well or producing formation _____

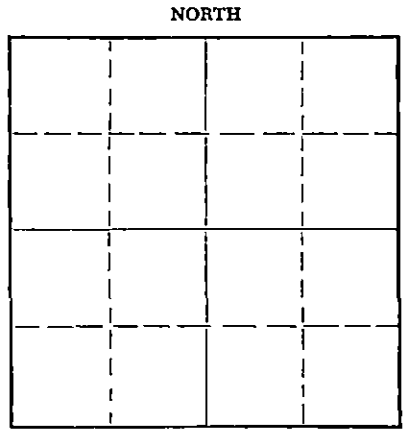

Locate well correctly on above
Section Plat

If a producing well is abandoned, date of last production _____ 19____
Was permission obtained from the Conservation Division or its agents before plugging was commenced? Yes

Name of Conservation Agent who supervised plugging of this well W. G. Buffington
Producing formation _____ Depth to top _____ Bottom _____ Total Depth of Well 4755 Feet
Show depth and thickness of all water, oil and gas formations.

OIL, GAS OR WATER RECORDS

CASING RECORD

FORMATION	CONTENT	FROM	TO	SIZE	PUT IN	PULLED OUT
				8-5/8	372	None

Describe in detail the manner in which the well was plugged, indicating where the mud fluid was placed and the method or methods used in introducing it into the hole. If cement or other plugs were used, state the character of same and depth placed, from _____ feet to _____ feet for each plug set.

Filled with heavy rotary mud from TD to 350'. Set plug @ 350' with 10 sax cement on top, filled with mud to 30' set plug with sack cotton seed hulls on top, set plug with 10 sax cement on top. Cement to top of casing & welded on steel plate. Filled to surface.

RECEIVED
STATE CORPORATION COMMISSION
SEP 10 1955
9-10-55
CONSERVATION DIVISION
Wichita, Kansas

(If additional description is necessary, use BACK of this sheet)
Name of Plugging Contractor Stickle Drilling Company
Address Tulsa, Oklahoma

STATE OF Kansas, COUNTY OF Barton, ss.
J. F. Dingee (employee of owner) or (owner or operator) of the above-described well, being first duly sworn on oath, says: That I have knowledge of the facts, statements, and matters herein contained and the log of the above-described well as filed and that the same are true and correct. So help me God.

(Signature) J. F. Dingee
Box 195, Great Bend, Kansas
(Address)

SUBSCRIBED AND SWORN TO before me this 9th day of September, 19 55

Willie
Notary Public.

My commission expires December 24, 1956

PLUGGING
FILE SEC 5 T 34 R 4W
BOOK PAGE 147 LINE 4

15-191-01519-00-00

Sunray Mid-Continent Oil Company
Tulsa, Oklahoma

Tulsa, Oklahoma
September 6, 1955

CONTRACTOR: Stickle Drilling Company
Drilling Commenced: August 12, 1955
Drilling Completed: September 2, 1955

Netahla #2 SW/4 S/2 NW/4
Sec. 5-34S-4W, Gerberding
Field, Sumner Co., Kansas.

DRILLERS LOG

Clay & Shale	0-70
Shale & Shells	70-815
Anhydrite	815-865
Shale & Salt	865-910
Shale & Lime	910-985
Shale, Shells & Salt	985-1050
Shale & Shells	1050-1110
Shale & Lime	1110-1265
Sandy Lime & Shale	1265-1445
Lime & Shale	1445-1570
Sandy Shale & Shells	1570-1780
Shale	1780-1960
Shale & Shells	1960-2570
Shale & Lime	2570-2630
Lime & Shale	2630-2725
Shale & Lime	2725-2845
Gray Lime & Shells	2845-2910
Shale & Lime	2910-3234
Shale & Sand	3234-3390
Gray Sand	3390-3480
Shale	3480-3618
Lime	3618-3729
Lime Kansas City	3729-3786
Lime	3786-3850
Lime & Shale	3850-3964
Shale & Lime	3964-4023
Lime & Shale	4023-4127
Shale & Lime	4127-4279
Shale	4279-4323
Lime & Chert	4323-4348
Cherty Lime	4348-4392
Mississippi	4392-4417
Lime	4417-4461
Mississippi	4461-4482
Lime	4482-4544
Mississippi	4544-4571
Lime	4571-4618
Shale & Lime	4618-4719
Shale	4719-4721
Sand	4721-4724
Simpson Sand	4724-4745
Sand	4745-4754 TD

I, Frank E. Stickle hereby certify the above to be a true and complete Drillers Log of Sunray Mid-Continent Oil Company's Netahla #2 SW/4 S/2 NW/4 Section 5-34S-4W, Gerberding Field, Sumner County, Kansas.

Frank E. Stickle
Frank E. Stickle

Lillian T. Bonham
Notary Public

February 13, 1956
My Commission Expires

PLUGGING
FILE SEC 5 T34 R4W
BOOK PAGE 147 LINE 4

RECEIVED
STATE OF KANSAS
OCT 17 1955

CONSERVATION DIVISION
Wichita, Kansas