


STATE OF KANSAS
STATE CORPORATION COMMISSION

15-191-20245-00-~~FOD~~CP-4

Give All Information Completely
Make Required Affidavit
Mail or Deliver Report to:
Conservation Division
State Corporation Commission
212 No. Market
Wichita, Kansas

WELL PLUGGING RECORD

NORTH

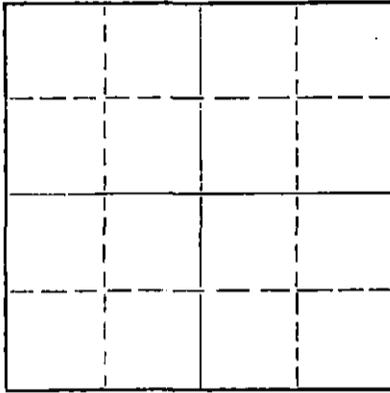

Locate well correctly on above
Section Plat

Sumner County. Sec. 6 Twp. 34S Rge. 4 (W) (NE)
Location as "NE/CNW/SW" or footage from lines 150' NW C NW SE
Lease Owner Mack Oil Company
Lease Name Netahla Well No. 3
Office Address 812 Union Center, Wichita, Kansas 67202
Character of Well (completed as Oil, Gas or Dry Hole) Dry Hole
Date well completed November 16 19 70
Application for plugging filed November 17 19 70
Application for plugging approved November 17 19 70
Plugging commenced November 16 19 70
Plugging completed November 16 19 70
Reason for abandonment of well or producing formation Dry Hole

If a producing well is abandoned, date of last production _____ 19____
Was permission obtained from the Conservation Division or its agents before plugging was commenced? yes

Name of Conservation Agent who supervised plugging of this well Howard Hess, Winfield, Kansas
Producing formation _____ Depth to top _____ Bottom _____ Total Depth of Well 4769 Feet
Show depth and thickness of all water, oil and gas formations. RTD

OIL, GAS OR WATER RECORDS

CASING RECORD

FORMATION	CONTENT	FROM	TO	SIZE	PUT IN	PULLED OUT
				8 5/8"	237'@ 246'	

Describe in detail the manner in which the well was plugged, indicating where the mud fluid was placed and the method or methods used in introducing it into the hole. If cement or other plugs were used, state the character of same and depth placed, from _____ feet to _____ feet for each plug set.

Plugged with 30 sx @ 240'
10 sx @ 40'
2 sx in rat hole

Plug down 1:00 p.m., November 16, 1970


RECEIVED
STATE CORPORATION COMMISSION
NOV 18 1970
CONSERVATION DIVISION
Wichita, Kansas

(If additional description is necessary, use BACK of this sheet)
Name of Plugging Contractor Thomas Drilling Co., Inc.
Address P.O. Box 400, Duncan, Oklahoma 73533

STATE OF KANSAS, COUNTY OF SEDGWICK, ss.
Eldon J. Schierling (employee of owner) or (owner or operator) of the above-described well, being first duly sworn on oath, says: That I have knowledge of the facts, statements, and matters herein contained and the log of the above described well as filed and that the same are true and correct. So help me God.

(Signature) Eldon J. Schierling
812 Union Center, Wichita, Kansas 67202
(Address)

Subscribed and sworn to before me this 17th day of November, 19 70

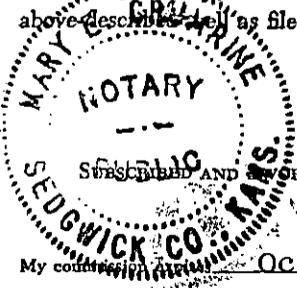

Mary E. Crumrine
Mary E. Crumrine Notary Public.

My commission expires October 15, 1974

MACK OIL COMPANY

BOX 400

DUNCAN, OKLA.

Memorandum

TO State Corporation Commission DATE 11-19-70

NOTE AND FILE
NOTE AND RETURN
APPROVE AND RETURN
IMMEDIATE ACTION
ADVISE
TAKE CHARGE OF THIS
ORDER AS NOTED
YOUR INFORMATION
PLEASE TELEPHONE

Re: Drillers Well Log
#3 Netahla 150' NW of C NW SE - Section 6-34S-4W
Sumner County, Kansas

Please substitute this well log for one previously sent with the plugging affidavit and record. There is a correction.

Thank you

RECEIVED
STATE CORPORATION COMMISSION
NOV 20 1970
Conservation Division
Wichita, Kansas

Mary E. Purvine
Secretary SIGNATURE
Mack Oil Company

15-191-20245-00-00

MACK OIL COMPANY
Duncan, Oklahoma
73533

DRILLERS WELL LOG

#3 NETAHLA

150' NW of C NW SE - SECTION 6-34S-4W
Sumner County, Kansas

Commenced R.D.: 11- 5-70
Completed R.D.: 11-16-70
Rotary Total Depth: 4769'

Elevation: 1250 K.B.
Initial Production: Dry Hole
Contractor: Thomas Drilling Co., Inc.

STRATA	DEPTH
Surface Soil	0 - 4
Red Bed	4 - 70
Shale	70 - 247
Red bed, shale	247 - 1055
Lime	1055 - 1777
Shale	1777 - 2544
Shale, lime	2544 - 2831
Lime	2831 - 3266
Lime, shale	3266 - 3400
Shale, sand	3400 - 3577
Lime, shale	3577 - 3635
Lime	3635 - 4735
Sand	4735 - 4769 RTD

RECEIVED
STATE CORPORATION COMMISSION
NOV 20 1970
CONSERVATION DIVISION
Wichita, Kansas

I hereby certify that the above is a true and correct log of said well as reflected by the daily drilling reports.

MACK OIL COMPANY

Eldon J. Schierling
Eldon J. Schierling



and sworn to in my presence
this 17th day of November, 1970.

My commission expires:

October 15, 1974

Mary E. Crumrine
Mary E. Crumrine, Notary Public