

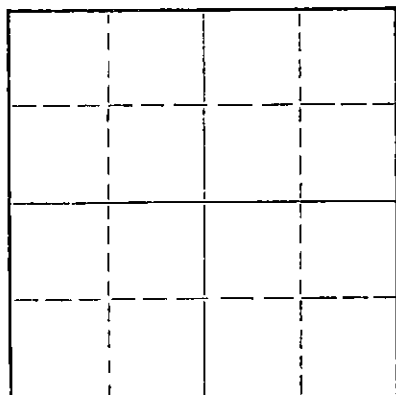
STATE OF KANSAS
STATE CORPORATION COMMISSION

Form CP-4

Give All Information Completely
Make Required Affidavit
Mail or Deliver Report to:
Conservation Division
State Corporation Commission
212 No. Market
Wichita, Kansas

WELL PLUGGING RECORD

NORTH

Locate well correctly on above
Section Plat

Pratt County, Sec. 12 Twp. 28S Rge. (E) 13 (W)
Location as "NE/CNW/SW" or footage from lines C-N/2-W/2-NW
Lease Owner Wm Gruenerwald and Associates, Incorporated
Lease Name Fincham Well No. 1
Office Address P. O. Box 909, Colorado Springs, Colorado
Character of Well (completed as Oil, Gas or Dry Hole) Dry Hole
Date well completed October 16 19 66
Application for plugging filed October 16 19 66
Application for plugging approved October 16 19 66
Plugging commenced October 16 19 66
Plugging completed October 16 19 66
Reason for abandonment of well or producing formation No producable shows

If a producing well is abandoned, date of last production 19
Was permission obtained from the Conservation Division or its agents before plugging was commenced? Yes

Name of Conservation Agent who supervised plugging of this well Archie V. Elving
Producing formation Depth to top Bottom Total Depth of Well 4350 Feet
Show depth and thickness of all water, oil and gas formations.

OIL, GAS OR WATER RECORDS

CASING RECORD

FORMATION	CONTENT	FROM	TO	SIZE	PUT IN	PULLED OUT
				13 3/8"	181'	
				8 5/8"	693'	

Describe in detail the manner in which the well was plugged, indicating where the mud fluid was placed and the method or methods used in introducing it into the hole. If cement or other plugs were used, state the character of same and depth placed, from feet to feet for each plug set.

Heavy mud to 400', 1 sx dry cement, 1/2 sx hulls, wooden plug and 24 sx cement.
Heavy mud to 40', 1 sx dry cement, 1/2 sx hulls and 9 sx cement. Plugged rat
hole with 2 sx cement. Job completed 9:45 AM, 10-16-66.

RECEIVED
STATE CORPORATION COMMISSION

FEB 14 1967

CONSERVATION DIVISION
Wichita, Kansas

(If additional description is necessary, use BACK of this sheet)

Name of Plugging Contractor Garvey Drilling Company
Address Route 2, Great Bend, Kansas

STATE OF Kansas, COUNTY OF Barton, ss.
George M. McKown

(employee of owner) or (owner or operator) of the above-described well, being first duly sworn on oath, says: That I have knowledge of the facts, statements, and matters herein contained and the log of the above-described well as filed and that the same are true and correct. So help me God.

(Signature)

Garvey Drilling Company, Route 2, Great Bend,
(Address) Kansas

SUBSCRIBED AND SWORN TO before me this 21st day of November, 19 66

My commission expires May 28, 1969

Notary Public.

WELL LOG

COMPANY William Gruenerwald and Associates, Inc.

SEC. 12 T. 28S R. 13W

FARM Fincham

NO. 1

LOC. C N/2 N/2

TOTAL DEPTH 4350'

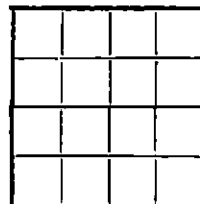
COUNTY Pratt

COMM. 10-4-66

COMP. 10-16-66

CONTRACTOR Garvey Drilling Company

CASING

13 5/8" @ 180' w/320 sx
8 5/8" @ 693' w/425 sx

ELEVATION

PRODUCTION D & A

FIGURES INDICATE BOTTOM OF FORMATIONS

120' Sand
181' Red Bed
220' Shale and Red Bed
680' Red Bed
715' Anhydrite
1000' Red Bed and Shale
1640' Shale
1715' Shale and Lime
1800' Shale with Lime Streaks
1925' Lime and Shale
2427' Lime
2635' Lime and Shale
2900' Shale and Lime
2953' Shale with Lime
3325' Lime and Shale
3420' Shale and Lime
3720' Lime and Shale
4105' Lime
4169' Lime and Shale
4233' Lime and Chert
4247' Lime and Shale
4295' Chert and Shale
4329' Chert and Lime with Shale
4350' Lime and Shale
4350' RTD

RECEIVED
STATE CORPORATION COMMISSION

FEB 13 1967

CONSERVATION DIVISION
Wichita, Kansas

State of KansasCounty of BartonI, Sam H. Stephensof Garvey Drilling CompanyFincham No. 1

upon oath state the above and foregoing is a true and correct copy of the log of the _____ well.

Subscribed and sworn to before me this 26th day of October 19 66

November 5th, 1966

My Commission Expires: _____

Richard L. Doy
NOTARY PUBLIC