


STATE OF KANSAS
STATE CORPORATION COMMISSION

Form CP-4

WELL PLUGGING RECORD

Give All Information Completely
Make Required Affidavit
Mail or Deliver Report to:
Conservation Division
State Corporation Commission
212 No. Market
Wichita, Kansas

NORTH

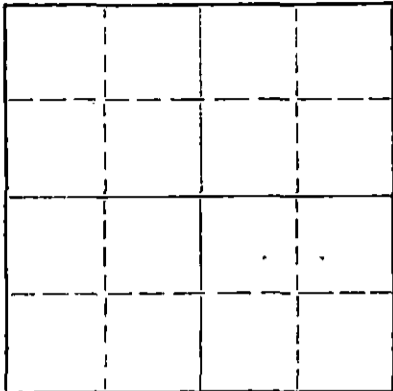

Locate well correctly on above
Section Plat

Pratt

County, Sec. 12 Twp. 28S Rge. 18 (E) 18 (W)

Location as "NE/CNW/SW" or footage from lines Approx. SW NW

Lease Owner William Gruenerwald and Associates, Inc.

Lease Name Hodgins Well No. 1

Office Address P. O. Box 909 Colorado Springs, Colorado

Character of Well (completed as Oil, Gas or Dry Hole) Dry Hole

Date well completed 7-18 19 66

Application for plugging filed 7-18 19 66

Application for plugging approved 7-18 19 66

Plugging commenced 7-18 19 66

Plugging completed 7-18 19 66

Reason for abandonment of well or producing formation No producible shows

If a producing well is abandoned, date of last production _____ 19 _____

Was permission obtained from the Conservation Division or its agents before plugging was commenced? Yes

Name of Conservation Agent who supervised plugging of this well Archie V. Elving

Producing formation _____ Depth to top _____ Bottom _____ Total Depth of Well _____ Feet

Show depth and thickness of all water, oil and gas formations.

OIL, GAS OR WATER RECORDS

CASING RECORD

FORMATION	CONTENT	FROM	TO	SIZE	PUT IN	PULLED OUT
				13 3/8	178'	
				8 5/8	697'	

Describe in detail the manner in which the well was plugged, indicating where the mud fluid was placed and the method or methods used in introducing it into the hole. If cement or other plugs were used, state the character of same and depth placed, from _____ feet to _____ feet for each plug set.

Displaced heavy mud through drill pipe to 400', bridged w/1/2 sx hulls, wood plug and 25 sx cement. Heavy mud to 40', bridged w/1/2 sx hulls, wooden plug and 10 sx cement to base of cellar. Plugged rat hole w/2 sx cement. Job complete 9:45 AM, 7-18-66.

RECEIVED
STATE CORPORATION COMMISSION
SEP 20 1966
9-28-66
WICHITA, KANSAS

(If additional description is necessary, use BACK of this sheet)
Name of Plugging Contractor Garvey Drilling Company
Address Route 2, Great Bend, Kansas

STATE OF Kansas, COUNTY OF Barton, ss.
Sam N. Stephens (employee of owner) or ~~owner~~ of the above-described

well, being first duly sworn on oath, says: That I have knowledge of the facts, statements, and matters herein contained and the log of the above-described well as filed and that the same are true and correct. So help me God.

(Signature) Sam N. Stephens

Route 2, Great Bend, Kansas
(Address)

SUBSCRIBED AND SWORN TO before me this 27th day of September, 19 66

My commission expires November 5, 1969

Richard Boyce
Notary Public.

WELL LOG

COMPANY **Wm. Gruenewald & Associates**

SEC. 12 T26S R. 13W

FARM **Hodgins** NO. 1


LOC. Approx. SW NW

TOTAL DEPTH **4473'**

COUNTY **Fratt**

COMM. **7-6-66** COMP. **7-18-66**

CONTRACTOR **Garvey Drilling Company**

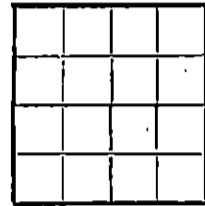

CASING **13 3/8" @ 178' w/325 sx**
8 5/8" @ 697' w/425 sx

ELEVATION **1837' DF**

PRODUCTION **D & A**

FIGURES INDICATE BOTTOM OF FORMATIONS

- 101' Surface Soil and Sand
- 158' Sand
- 173' Red Bed
- 420' Shale
- 682' Red Bed and Shale
- 710' Anhydrite
- 1060' Shale and Shells
- 1720' Shale
- 1760' Shale and Lime
- 2360' Lime and Shale
- 2721' Shale and Lime
- 3835' Lime and Shale
- 4185' Lime
- 4244' Lime and Chert
- 4359' Chert and Lime
- 4364' Chert and Sand
- 4379' Simpson
- 4402' Sand
- 4415' Simpson
- 4434' Sand
- 4473' Chert and Sand
- 4473' RTD

RECEIVED
STATE CORPORATION COMMISSION
OCT 3 1966
CONSERVATION DIVISION
Wichita, Kansas

State of Kansas
County of Barton } SS

I, Sam N. Stephens of Garvey Drilling Company

upon oath state the above and foregoing is a true and correct copy of the log of the Hodgins No. 1 well.

Subscribed and sworn to before me this 9th day of August 1966

My Commission Expires: May 28, 1969
Richard H. Dumbler
NOTARY PUBLIC