


WELL PLUGGING RECORD

Give All Information Completely
Make Required Affidavit
Mail or Deliver Report to:
Conservation Division
State Corporation Commission
211 No. Broadway
Wichita, Kansas

Pratt County. Sec. 11 Twp. 28S Rge. (E) 13 (W)
Location as "NE/CNW'SW" or footage from lines C SW SE
Lease Owner Braden Drilling, Inc.
Lease Name Devlin Well No. 1
Office Address 1620 Wichita Plaza Bldg., Wichita, Kansas
Character of Well (completed as Oil, Gas or Dry Hole) Dry Hole
Date well completed October 23, 1965
Application for plugging filed October 23, 1965
Application for plugging approved October 23, 1965
Plugging commenced October 23, 1965
Plugging completed October 23, 1965
Reason for abandonment of well or producing formation D & A

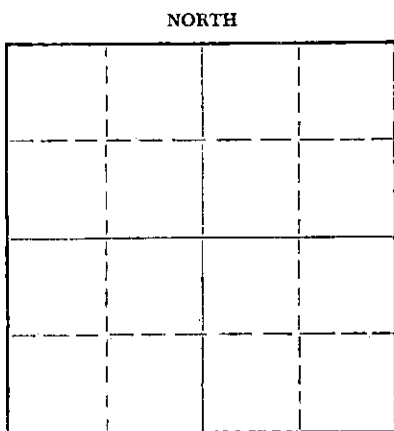

Locate well correctly on above
Section Plat

If a producing well is abandoned, date of last production 19
Was permission obtained from the Conservation Division or its agents before plugging was commenced? Yes

Name of Conservation Agent who supervised plugging of this well Archie V. Elving, Box 248, Pratt, Kansas
Producing formation - Depth to top - Bottom - Total Depth of Well 4559 Feet
Show depth and thickness of all water, oil and gas formations.

OIL, GAS OR WATER RECORDS

CASING RECORD

FORMATION	CONTENT	FROM	TO	SIZE	PUT IN	PULLED OUT
	Surface casing			13-3/8"	211'	none
	Surface casing			8-5/8"	766'	none

Describe in detail the manner in which the well was plugged, indicating where the mud fluid was placed and the method or methods used in introducing it into the hole. If cement or other plugs were used, state the character of same and depth placed, from feet to feet for each plug set.

Mud to 300'. Set first plug at 300' cemented with 1/3 sack of hulls and 25 sacks of cement. Second plug set at 40' cemented with 1/3 sack of hulls and 10 sacks of cement. Two sacks of cement in the rat hole.

RECEIVED
STATE CORPORATION COMMISSION

OCT 28 1965

CONSERVATION DIVISION
Wichita, Kansas

(If additional description is necessary, use BACK of this sheet)

Name of Plugging Contractor Braden Drilling, Inc.
Address 1620 Wichita Plaza Bldg, Wichita, Kansas

STATE OF Kansas, COUNTY OF Sedgwick, ss.
James Tasheff (employee of owner) or (owner or operator) of the above-described

well, being first duly sworn on oath, says: That I have knowledge of the facts, statements, and matters herein contained and the log of the above-described well as filed and that the same are true and correct. So help me God.

(Signature) James Tasheff
1620 Wichita Plaza Bldg, Wichita, Kansas
(Address)

SUBSCRIBED AND SWORN TO before me this 27th day of October, 19 65

My commission expires March 21, 1966

William Schmitt Notary Public.

DRILLER'S LOG

Braden Drilling, Inc.
 DEVLIN #1
 C SW SE Sec. 11-28S-13W
 Pratt County, Kansas

Commenced: October 7, 1965
 Completed: October 23, 1965

Set 13-3/8" surface casing at 211'
 and cemented with 300 sacks of HA-5
 Pozmix.

Set 8-5/8" surface casing at 766'
 and cemented with 300 sacks of HA-5
 Pozmix.

RECEIVED
 STATE CORPORATION COMMISSION

OCT 28 1965

CONSERVATION DIVISION
 WICHITA, KANSAS

<u>Formation</u>	<u>From</u>	<u>To</u>
Surface clay and sand	0	168
Red bed	168	280
Red bed and Sand	280	322
Sand and shale	322	440
Red bed	440	705
Anhydrite	705	721
Sand and shale	721	756
Anhydrite	756	776
Red bed and shale	776	1150
Shale	1150	1600
Shale and lime	1600	2080
Lime	2080	2380
Shale and lime	2380	2900
Limy shale	2900	3055
Lime and shale	3055	3725
Shale and sand	3725	3795
Lime and shale	3795	3835
Lime	3835	4267
Cherty lime	4267	4334
Lime and chert	4334	4438
Lime and sand	4438	4452
Sand	4452	4488
Lime, sand and some chert	4488	4530
Lime	4530	4559 T.D.

I hereby certify that this is a true and correct log of the above captioned well as shown by the daily drilling reports.

James Tasheff
 James Tasheff

Subscribed and sworn to before me this 26th day of October, 1965.

My commission expires March 21, 1966

Helena Schubert
 Notary Public