


STATE OF KANSAS
STATE CORPORATION COMMISSION
CONSERVATION DIVISION
P. O. BOX 17027
WICHITA, KANSAS 67217

FORM CP-4

WELL PLUGGING RECORD

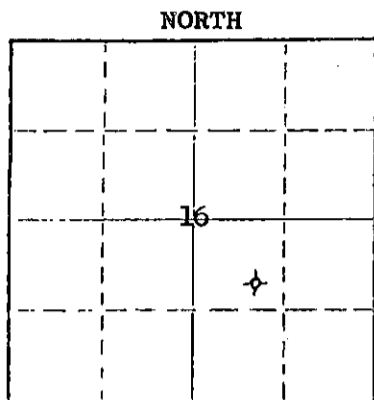

Locate well correctly on above Section Plat

Pratt County, Sec. 16 Twp. 28S Rge. 13W (W) (W)
Location as "NE/CNWxSWx" or footage from lines SE NW SE
Lease Owner Petrie Enterprises, Inc.
Lease Name Swisher Well No. 1
Office Address R.R. 1, Pratt, Kansas 67124
Character of Well (completed as Oil, Gas or Dry Hole) Lost circulation, skid rig.
Date well completed December 15, 1977
Application for plugging filed December 15, 1977
Application for plugging approved December 15, 1977
Plugging commenced December 15, 1977
Plugging completed December 15, 1977
Reason for abandonment of well or producing formation Lost circulation, skid rig 15' south.
If a producing well is abandoned, date of last production _____ 19____
Was permission obtained from the Conservation Division or its agents before plugging was commenced? Yes

Name of Conservation Agent who supervised plugging of this well _____
Producing formation _____ Depth to top _____ Bottom _____ Total Depth of Well 1153 feet
Show depth and thickness of all water, oil and gas formations.

OIL, GAS OR WATER RECORDS

CASING RECORD

FORMATION	CONTENT	FROM	TO	SIZE	PUT IN	FULLED OUT
		0'	204'	8-5/8"	197.69'	None

Describe in detail the manner in which the well was plugged, indicating where the mud fluid was placed and the method or methods used in introducing it into the hole. If cement or other plugs were used, state the character of same and depth placed, from _____ feet to _____ feet for each plug set.

Plug at 150', 60 sacks 50-50 Pozmix Cement and 2% calcium chloride to top of surface pipe.

RECEIVED
STATE CORPORATION COMMISSION

JAN 25 1978

(If additional description is necessary, use BACK of this sheet)
Name of Plugging Contractor Halliburton Cementing Co.
Address Box 963, Pratt, Kansas 67124 CONSERVATION DIVISION
Wichita, Kansas

STATE OF KANSAS COUNTY OF SEDGWICK, ss.
John D. Knightley, Agent (employee of owner) or (owner or operator) of the above-described

well, being first duly sworn on oath, says: That I have knowledge of the facts, statements, and matters herein contained and the log of the above-described well as filed and that the same are true and correct. So help me God.

(Signature) [Signature]
221 S. Broadway, Wichita, Kansas 67202
(Address)

SUBSCRIBED AND SWORN TO before me this 24th day of January, 1978

My commission expires March 12, 1979

[Signature]
Notary Public.

Petrie Enterprises, Inc. - Swisher #1
SE NW SE Sec. 16-28S-13W
Pratt County, Kansas

Contractor: D. R. Lauck Oil Company, Inc.
221 S. Broadway, Suite 400
Wichita, Kansas 67202

Commenced: December 12, 1977
Completed: December 15, 1977

Drillers Log

Clay	35
Sand	175
Red Bed	1153

Lost Circulation--Skid Rig 15' south.

RECEIVED
STATE OF KANSAS COMMISSION
JAN 25 1978
OIL AND GAS DIVISION
Wichita, Kansas