

S  
SIDE ONE

STATE CORPORATION COMMISSION OF KANSAS  
OIL & GAS CONSERVATION DIVISION  
WELL COMPLETION FORM  
ACO-1 WELL HISTORY  
DESCRIPTION OF WELL AND LEASE

API NO. 15- 191-22,128-00-00

County Sumner

NE NE NW Sec. 23 Twp. 34 Rge. 2 X East West

4950 Ft. North from Southeast Corner of Section

3020 Ft. West from Southeast Corner of Section

(NOTE: Locate well in section plat below.)


Lease Name CRANE "A" Well # 1

Field Name Corbin

Producing Formation \_\_\_\_\_

Elevation: Ground 1114 KB 1119

Total Depth 4700 PBTD \_\_\_\_\_

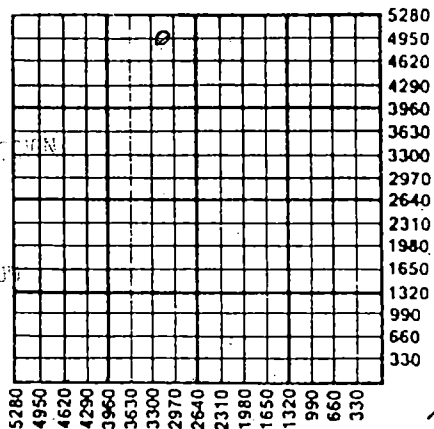

Amount of Surface Pipe Set and Cemented at 257 Feet

Multiple Stage Cementing Collar Used? \_\_\_\_\_ Yes X No

If yes, show depth set \_\_\_\_\_ Feet

If Alternate II completion, cement circulated from \_\_\_\_\_

feet depth to \_\_\_\_\_ w/ \_\_\_\_\_ sx cmt.

Operator: License # 3667

Name: SOURCE PETROLEUM

Address 200 W. Douglas, Suite 820

Wichita, KS 67202

City/State/Zip \_\_\_\_\_

Purchaser: \_\_\_\_\_

Operator Contact Person: John D. Howard, JR.

Phone (316) 262-7397

Contractor: Name: ALLEN DRILLING COMPANY

License: 5418

Wellsite Geologist: Timothy Pierce

Designate Type of Completion

X New Well \_\_\_\_\_ Re-Entry \_\_\_\_\_ Workover \_\_\_\_\_

\_\_\_\_\_ Oil \_\_\_\_\_ SWD \_\_\_\_\_ Temp. Abd.

\_\_\_\_\_ Gas \_\_\_\_\_ Inj \_\_\_\_\_ Delayed Comp.

X Dry \_\_\_\_\_ Other (Core, Water Supply, etc.)

If OWO: old well info as follows:

Operator: \_\_\_\_\_

Well Name: \_\_\_\_\_

Comp. Date \_\_\_\_\_ Old Total Depth \_\_\_\_\_

Drilling Method:

X Mud Rotary \_\_\_\_\_ Air Rotary \_\_\_\_\_ Cable \_\_\_\_\_

9/02/89 9/12/89 9/13/89

Spud Date Date Reached TD Completion Date

RECEIVED  
STATE CORPORATION COMMISSION  
OCT 06 1989


INSTRUCTIONS: This form shall be completed in triplicate and filed with the Kansas Corporation Commission, 200 Colorado Derby Building, Wichita, Kansas 67202, within 120 days of the spud date of any well. Rule 82-3-130, 82-3-107 and 82-3-106 apply. Information on side two of this form will be held confidential for a period of 12 months if requested in writing and submitted with the form. See rule 82-3-107 for confidentiality in excess of 12 months. One copy of all wireline logs and drillers time log shall be attached with this form. ALL CEMENTING TICKETS MUST BE ATTACHED. Submit CP-4 form with all plugged wells. Submit CP-111 form with all temporarily abandoned wells. Any recompletion, workover or conversion of a well requires filing of ACO-2 within 120 days from commencement date of such work.

All requirements of the statutes, rules and regulations promulgated to regulate the oil and gas industry have been fully complied with and the statements herein are complete and correct to the best of my knowledge.

Signature John D. Howard, Jr.

Title General Manager Date 9/28/89

Subscribed and sworn to before me this 28th day of September

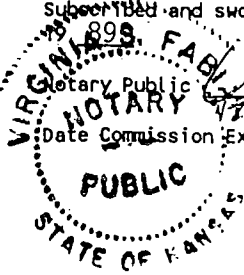

Virginia S. Fabian  
Notary Public  
Date Commission Expires August 5, 1991

K.C.C. OFFICE USE ONLY

Letter of Confidentiality Attached

Wireline Log Received

Drillers Timelog Received

Distribution

KCC \_\_\_\_\_ SWD/Rep \_\_\_\_\_ NGPA

KGS \_\_\_\_\_ Plug \_\_\_\_\_ Other \_\_\_\_\_

(Specify)

PTX