


STATE OF KANSAS  
STATE CORPORATION COMMISSION

15-025-10083-00-00

Give All Information Completely  
Make Required Affidavit  
Mail or Deliver Report to:  
Conservation Division  
State Corporation Commission  
211 No. Broadway  
Wichita, Kansas

WELL PLUGGING RECORD

NORTH

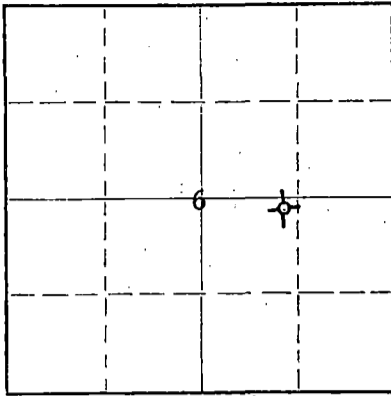

Locate well correctly on above Section Plat

Clark County. Sec. 6 Twp. 34 Rge. (E) 21 (W)  
Location as "NE/CNW/SW" or footage from lines Aprox. 50' s & w of C E/2  
Lease Owner Graham-Michaelis Drilling Company  
Lease Name Dome Well No. 1-6  
Office Address 211 North Broadway, Wichita 2, Kansas  
Character of Well (completed as Oil, Gas or Dry Hole) Dry Hole  
Date well completed March 31, 19 62  
Application for plugging filed March 31, 19 62  
Application for plugging approved March 31, (verbal approval) 19 62  
Plugging commenced March 31, 19 62  
Plugging completed March 31, 19 62  
Reason for abandonment of well or producing formation Dry Hole

If a producing well is abandoned, date of last production ----- 19  
Was permission obtained from the Conservation Division or its agents before plugging was commenced? Yes

Name of Conservation Agent who supervised plugging of this well Fred W. Hampel, Pretty Prairie, Kansas  
Producing formation none Depth to top --- Bottom --- Total Depth of Well 5514 Feet  
Show depth and thickness of all water, oil and gas formations.

OIL, GAS OR WATER RECORDS

CASING RECORD

FORMATION	CONTENT	FROM	TO	SIZE	PUT IN	PULLED OUT
				8 5/8"	@ 655'	none

Describe in detail the manner in which the well was plugged, indicating where the mud fluid was placed and the method or methods used in introducing it into the hole. If cement or other plugs were used, state the character of same and depth placed, from feet to feet for each plug set.

Filled hole with heavy mud to 300', dumped 40 sax cement on top. Filled hole with heavy mud to 35', cemented to top with 10 sax cement.

RECEIVED  
STATE CORPORATION COMMISSION  
APR 4 1962  
CONSERVATION DIVISION  
Wichita, Kansas

(If additional description is necessary, use BACK of this sheet)

Name of Plugging Contractor Graham-Michaelis Drilling Company  
Address 211 North Broadway, Wichita 2, Kansas

STATE OF Kansas, COUNTY OF Sedgwick, ss.  
John L. James (employee of owner) ~~but (operator) of the above-described well, being first duly sworn on oath, says: That I have knowledge of the facts, statements, and matters herein contained and the log of the above-described well as filed and that the same are true and correct. So help me God.~~

(Signature) John L. James - Geologist  
211 North Broadway, Wichita 2, Kansas  
(Address)

SUBSCRIBED AND SWORN TO before me this 2nd day of April, 19 62

Evelyn D. Evans  
Evelyn D. Evans Notary Public.

My commission expires December 12, 1962



6 15-025-10083-00-00

DOME #1-6

WELL RECORD:

LOCATION:

Section 6-34S-21W  
Clark County, Kansas

Commenced: 3/16/62  
Completed: 4/1/62  
(Rotary)

CONTRACTOR:

Graham-Michaelis Drilling Co.  
Liberal Division  
P. O. Box 896  
Liberal, Kansas

CASING RECORD:

20 Joints 8-5/8" Casing  
Cemented w/150 sx Lite Wt. 2% cc  
1/2" F.C. followed w/200 sx Sunset

**RECEIVED**  
STATE CORPORATION COMMISSION

APR 6 1962

**CONSERVATION DIVISION**  
Wichita, Kansas

	<u>LOG</u>
Sand & Surface Clay	0 - 147
Sand & Red Bed	147 - 740
Red Bed	740 - 1097
Shale & Anhy	1097 - 2555
Shale & Lime	2555 - 3460
Shale & Chalky Lime	3460 - 3617
Shale & Lime	3617 - 3753
Shale & Chalky Lime	3753 - 3909
Shale & Lime	3909 - 5100
Lime	5100 - 5183
Lime & Shale	5183 - 5514

5514' - Total Rotary Depth

The undersigned, Graham-Michaelis Drilling Company, Liberal Division, certifies that the above log is a true and correct copy of the formations encountered in drilling the above mentioned well, as taken from the Daily Drilling Report.

GRAHAM-MICHAELIS DRILLING COMPANY  
LIBERAL DIVISION

By H. R. Michaelis  
H. R. Michaelis