


15-025-00086-00-00

STATE OF KANSAS
STATE CORPORATION COMMISSION

Give All Information Completely
Make Required Affidavit
Mail or Deliver Report to:
Conservation Division
State Corporation Commission
800 Biting Building
Wichita, Kansas

WELL PLUGGING RECORD

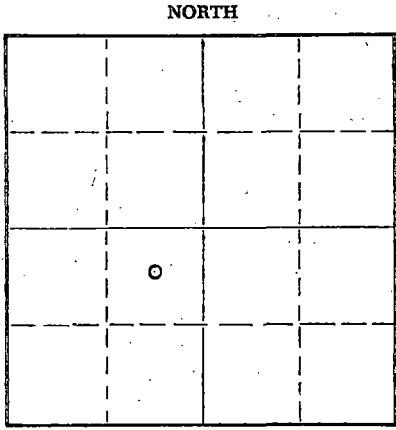

Locate well correctly on above Section Plat

Clark County, Sec. 8 Twp. 34S Rge. 21 (E) (W)
Location as "NE/CNW/SW" or footage from lines C NE SW
Lease Owner United Producing Company, Inc.
Lease Name Jessie G. Harper Well No. 2
Office Address P. O. Drawer 30, Liberal, Kansas
Character of Well (completed as Oil, Gas or Dry Hole) Dry Hole
Date well completed September 24 19 53
Application for plugging filed March 15 19 55
Application for plugging approved March 16 19 55
Plugging commenced March 17 19 55
Plugging completed March 17 19 55
Reason for abandonment of well or producing formation Dry Hole

If a producing well is abandoned, date of last production -- 19
Was permission obtained from the Conservation Division or its agents before plugging was commenced? Yes

Name of Conservation Agent who supervised plugging of this well W. H. Horner
Producing formation None productive Depth to top Bottom Total Depth of Well 5557 Feet
Show depth and thickness of all water, oil and gas formations.

OIL, GAS OR WATER RECORDS

CASING RECORD

FORMATION	CONTENT	FROM	TO	SIZE	PUT IN	PULLED OUT
Red Shale & Sand	Fresh Water	0'	100'	20"	102'	None
Shale & Lime		100'	500'	13-3/8"	497'	None
Red Bed & Salt	Salt Mass	500'	940'	8-5/8"	2390'	None

Describe in detail the manner in which the well was plugged, indicating where the mud fluid was placed and the method or methods used in introducing it into the hole. If cement or other plugs were used, state the character of same and depth placed, from feet to feet for each plug set.

Plugging Data: Halliburton pumped 80 sax cement inside 8-5/8" from surface to 240 feet. Pumped 20 sax outside 8-5/8" casing.

3-22-55
STATE CORPORATION COMMISSION
WICHITA, KANSAS

(If additional description is necessary, use BACK of this sheet)

Name of Plugging Contractor Company
Address Drawer 30, Liberal, Kansas

STATE OF KANSAS, COUNTY OF SEWARD, ss.
A. H. Pannell (employee of owner) or (owner or operator) of the above-described well, being first duly sworn on oath, says: That I have knowledge of the facts, statements, and matters herein contained and the log of the above-described well as filed and that the same are true and correct. So help me God.

(Signature) A. H. Pannell
Drawer 30, Liberal, Kansas (Address)

SUBSCRIBED AND SWORN to before me this 19th day of March, 19 55

Conrad J. Davis Notary Public.

My commission expires April 16, 1956

PLUGGING
FILE SEC 8 T 34 S 21W
BOOK PAGE 105 LINE 24

15-02500086-00-00

UNITED PRODUCING COMPANY

JESSE C. HARPER #2

CLARK COUNTY, KANSAS

NE/4 - SW/4 - 8-348-21W

PARKER DRILLING COMPANY

Spudded 8/25/53

Complete 9/24/53

<u>FORMATION</u>	<u>FROM</u>	<u>TO</u>
Red Bed	0	104
Red Bed & Gyp	104-	497
Red Bed & Salt	497	1364
Red Bed, Gyp & Shells	1364	2058
Lime & Shale	2058	2201
Red Bed, Lime & Shale	2201	2297
Shale Lime & Salt	2297	2401
Shale, Lime & Gyp	2401	2442
Shale & Sand	2442	2592
Lime & Shale	2592	3833
Shale	3833	3921
Lime & Shale	3921	5303
Lime, Shale & Chert	5303	5394
Lime & Shale	5394	5445
Lime, Shale & Sand	5445	5487
Shale & Sand	5487	5496
Lime, Shale & Sand	5496	5555 TD

FILED
STATE COMMISSION
MAR 17 1955
CONSERVATION DIVISION
Wichita, Kansas

PLUGGING
 FILE NO.
 BOOK PAGE LINE