


WELL PLUGGING RECORD

Get All Information Completely
Make Record and Affidavit
Mail or Deliver Report to:
Conservation Division
State Corporation Commission
211 No. Broadway
Wichita, Kansas

Clark County. Sec. 10 Twp. 34S Rge. (E) 21W (W)

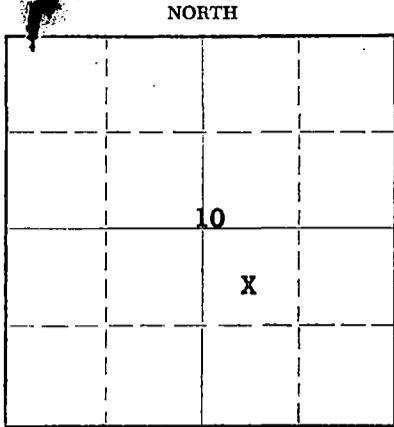

Locate well correctly on above Section Plat

Location as "NE/CNW/SW" or footage from lines NW SE
Lease Owner Ashland Oil & Refining Co.
Lease Name J. F. Harper Well No. 1-10
Office Address Box 18695, Okla. City, Oklahoma 73118
Character of Well (completed as Oil, Gas or Dry Hole) Oil
Date well completed 1-17-54 19
Application for plugging filed 6-3-69 19
Application for plugging approved 6-4-69 19
Plugging commenced 7-17-69 19
Plugging completed 7-23-69 19
Reason for abandonment of well or producing formation Depleted

If a producing well is abandoned, date of last production _____ 19
Was permission obtained from the Conservation Division or its agents before plugging was commenced? Yes

Name of Conservation Agent who supervised plugging of this well E. Eves
Producing formation Marmaton Depth to top 5096 Bottom 5150 Total Depth of Well 5550 Feet
Show depth and thickness of all water, oil and gas formations.

OIL, GAS OR WATER RECORDS

CASING RECORD

FORMATION	CONTENT	FROM	TO	SIZE	PUT IN	PULLED OUT
Marmaton		5096	5104	8 5/8	2,380'	638'
				5 1/2"	5,536	4,013'

Describe in detail the manner in which the well was plugged, indicating where the mud fluid was placed and the method or methods used in introducing it into the hole. If cement or other plugs were used, state the character of same and depth placed, from _____ feet to _____ feet for each plug set.

Pumped 20 Sks Cement to 4800'. Filled hole with mud & worked 5 1/2" shot Csg @4013' pulled. Refilled hole with mud and worked 8 5/8" shot @1001', 903', 781', 638' worked loose. Pumped 40 Sks Cement from 500' to 400'. Pulled 8 5/8". Cut off 13 3/8' surface capped with 10 Sks and welded on steel plate.

RECEIVED
STATE CORPORATION COMMISSION
AUG 5 1969
CONSERVATION DIVISION
Wichita, Kansas

(If additional description is necessary, use BACK of this sheet)
Name of Plugging Contractor Gayle E. Toland & Co.
Address 1217 S. E. 29th, Okla. City, Oklahoma

STATE OF Oklahoma, COUNTY OF Oklahoma, ss.
Jack E. Precise, Div. Prod. Supt. (employee of owner) or (owner or operator) of the above-described well, being first duly sworn on oath, says: That I have knowledge of the facts, statements, and matters herein contained and the log of the above-described well as filed and that the same are true and correct. So help me God.

(Signature) Jack E. Precise
P.O. Box 18695, Okla. City, Okla. 73118
(Address)

SUBSCRIBED AND SWORN TO before me this 4th day of August, 19 69
Betty R. Adams
Notary Public.

My commission expires April 26, 1972

