

15-025-20732-00-00


STATE OF KANSAS
STATE CORPORATION COMMISSION

WELL PLUGGING RECORD

Give All Information Completely
Make Required Affidavit
Mail or Deliver Report to
Conservation Division
State Corporation Comm.
245 North Water
Wichita, KS 67202

Clark County. Sec. 10 Twp. 34S Rge. 21 ~~E~~/W
Location as "NE/CNW $\frac{1}{4}$ SW $\frac{1}{4}$ " or footage from lines

C SE SW.
Lease Owner Rine Drilling Company
Lease Name Harper Well No. 1-10
Office Address 300 W. Douglas, Ste. 600, Wichita, KS 67202
Character of Well (Completed as Oil, Gas or Dry Hole)
Dry Hole

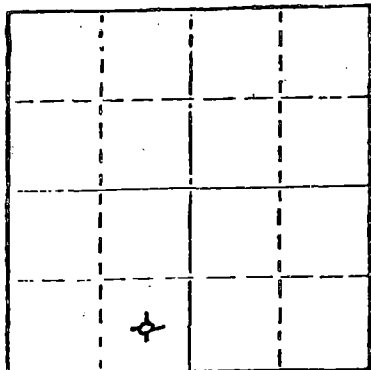

Locate well correctly on above
Section Plat

Date Well completed 10/20/83 19
Application for plugging filed 10/20/83 19
Application for plugging approved 10/20/83 19
Plugging commenced 10/20/83 19
Plugging completed 10/20/83 19
Reason for abandonment of well or producing formation
Dry Hole

If a producing well is abandoned, date of last production
N/A 19

Was permission obtained from the Conservation Division or
its agents before plugging was commenced? yes

Name of Conservation Agent who supervised plugging of this well Paul Luthi, Minneola, Kansas
Producing formation N/A Depth to top N/A Bottom N/A Total Depth of Well 5,586'
Show depth and thickness of all water, oil and gas formations.

OIL, GAS OR WATER RECORDS

CASING RECORD

FORMATION	CONTENT	FROM	TO	SIZE	PUT IN	PULLED OUT
	Conductor	0	88'	20"	yes	no
	Surface	0	858'KB	8-5/8"	yes	no

Describe in detail the manner in which the well was plugged, indicating where the mud fluid was placed and the method or methods used in introducing it into the hold. If cement or other plugs were used, state the character of same and depth placed, from _____ feet to _____ feet for each plug set.

1st plug @ 900' - 50 sx
2nd plug @ 450' - 40 sx
40' to -3' - 10 sx
Mousehole - 10 sx
Rathole - 10 sx
Completed @ 5:15 p.m. 5-20-83

(If additional description is necessary, use BACK of this sheet)

Name of Plugging Contractor Rine Drilling Company

STATE OF KANSAS COUNTY OF SEDGWICK, ss.
E. J. RINE (employee of owner) or (owner or operator)
of the above-described well, being first duly sworn on oath, says: That I have knowledge of the facts, statements, and matters herein contained and the log of the above-described well as filed and that the same are true and correct. So help me God.

(Signature) E. J. Rine President
300 W. Douglas, Ste. 600, Wichita, KS 67202
(Address)

SUBSCRIBED AND SWORN TO before me this 9th day of November, 19 83.

Donna K. McKee
Donna K. McKee, Notary Public.

My commission expires January 21, 1985

RECEIVED
STATE CORPORATION COMMISSION

NOV 10 1983

CONSERVATION DIVISION
Wichita, Kansas