


WELL PLUGGING RECORD

Give All Information Completely
Make Required Affidavit
Mail or Deliver Report to:
Conservation Division
State Corporation Commission
211 No. Broadway
Wichita, Kansas

Clark County, Sec. 12 Twp. 34S Rge. (E) 21 (W)

Location as "NE/CNW/SW" or footage from lines: Approx. C-NE/4
Lease Owner: Petroleum Inc.
Lease Name: Knop Unit Well No. 1
Office Address: P.O. Box 1255 Liberal, Kansas
Character of Well (completed as Oil, Gas or Dry Hole): Dry Hole
Date well completed: 12-29 1965
Application for plugging filed: 12-29 1965
Application for plugging approved: 12-29 1965
Plugging commenced: 12-29 1965
Plugging completed: 12-29 1965
Reason for abandonment of well or producing formation:

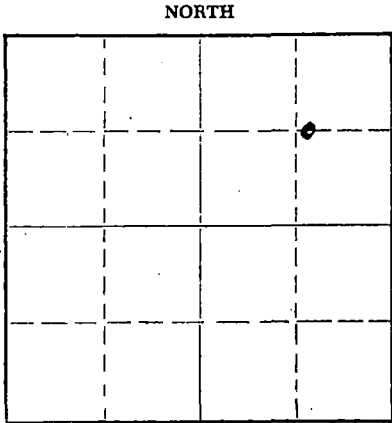

Locate well correctly on above Section Plat

If a producing well is abandoned, date of last production: 19____
Was permission obtained from the Conservation Division or its agents before plugging was commenced? Yes

Name of Conservation Agent who supervised plugging of this well: Hugh Scott
Producing formation: None Depth to top: Bottom: Total Depth of Well: 5504 Feet
Show depth and thickness of all water, oil and gas formations.

| OIL, GAS OR WATER RECORDS | | | | CASING RECORD | | |
|---------------------------|---------|------|----|---------------|--------|------------|
| FORMATION | CONTENT | FROM | TO | SIZE | PUT IN | PULLED OUT |
| | | | | 8-5/8" | 570' | None |
| | | | | | | |
| | | | | | | |
| | | | | | | |
| | | | | | | |
| | | | | | | |
| | | | | | | |
| | | | | | | |

Describe in detail the manner in which the well was plugged, indicating where the mud fluid was placed and the method or methods used in introducing it into the hole. If cement or other plugs were used, state the character of same and depth placed, from _____ feet to _____ feet for each plug set.

Mudded up with heavy mud from 5504' to 600' followed by 35 sacks cement from 600' to 500'.
Mudded up with heavy mud from 500' to 40' followed by 15 sacks cement to base of well cellar.

RECEIVED
STATE CORPORATION COMMISSION
JAN 6 1966
CONSERVATION DIVISION
WICHITA, KANSAS

(If additional description is necessary, use BACK of this sheet)
Name of Plugging Contractor: Garvey Drilling Co.
Address: R.R. # 2, Great Bend, Kansas

STATE OF Kansas COUNTY OF Seward, ss.
Harold L. Young (employee of owner) of the above-described well, being first duly sworn on oath, says: That I have knowledge of the facts, statements, and matters herein contained and the log of the above-described well as filed and that the same are true and correct. So help me God.

(Signature) Harold L. Young
P.O. Box 1255 Liberal, Kansas
(Address)

SUBSCRIBED AND SWORN TO before me this 5th day of January, 1966
Richard D. Junk
Notary Public.

My commission expires January 20, 1969

15-025-30083-00-00
WELL LOG

COMPANY Petroleum, Inc.

SEC. 12 T. 34S R. 21W

FARM Knopp Unit

NO. 1

LOC. C NE


TOTAL DEPTH 5504'

COUNTY Clark

COMM. 12-12-65

COMP. 12-29-65

CONTRACTOR Garvey Drilling Company

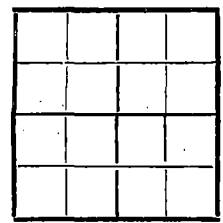

CASING 8 5/8" @ 570' w/400 sx

ELEVATION

PRODUCTION D & A

FIGURES INDICATE BOTTOM OF FORMATIONS

- 30' Red Bed
- 50' Sand and Shale
- 150' Shale
- 570' Red Rock and Shale
- 1855' Shale
- 2195' Shale and Lime
- 2307' Lime and Shale
- 2480' Lime, Shale and Dolomite
- 2635' Dolomite, Shale and Chalk
- 2725' Dolomite and Lime
- 4545' Lime and Shale
- 4616' Lime
- 4935' Lime and Shale
- 5210' Lime
- 5290' Lime and Shale
- 5400' Shale, Lime and Sand
- 5404' Shale
- 5440' Mississippi Lime and Shale
- 5480' Lime
- 5504' Lime and Shale
- 5504' RTD

State of Kansas

County of Barton

SS

I, Sam N. Stephens of Garvey Drilling Company

upon oath state the above and foregoing is a true and correct copy of the log of the Knopp Unit No. 1 well.

Sam N. Stephens

Subscribed and sworn to before me this 4th day of January 19 66

My Commission Expires: November 5, 1969

Richard A. Doy
NOTARY PUBLIC