


15-025-00045-00-00

STATE OF KANSAS
STATE CORPORATION COMMISSION

Form CP-4

Give All Information Completely
Make Required Affidavit
Mail or Deliver Report to:
Conservation Division
State Corporation Commission
P. O. Box 17027
Wichita, Kansas 67217
NORTH

WELL PLUGGING RECORD

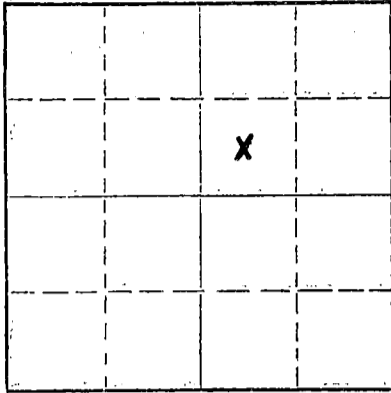

Locate well correctly on above
Section Plat

Clark County, Sec. 17 Twp. 34S Rge. 21W (E) (W)
Location as "NE/CNW/SW" or footage from lines C SW NE
Lease Owner J. M. Huber Corporation
Lease Name Harvey Well No. 1
Office Address 2450 Liberty Tower, Okla. City, Okla. 73102
Character of Well (completed as Oil, Gas or Dry Hole) Gas
Date well completed March 9 19 59
Application for plugging filed February 9 19 77
Application for plugging approved February 11 19 77
Plugging commenced February 24 19 77
Plugging completed March 2 19 77
Reason for abandonment of well or producing formation Well depleted in producing interval with no additional prospective zones.
If a producing well is abandoned, date of last production February 19 77
Was permission obtained from the Conservation Division or its agents before plugging was commenced? Yes

Name of Conservation Agent who supervised plugging of this well Clarence Thomas
Producing formation Morrow Depth to top 5373' Bottom 5485' Total Depth of Well 5592 Feet
Show depth and thickness of all water, oil and gas formations.

OIL, GAS OR WATER RECORDS

CASING RECORD

FORMATION	CONTENT	FROM	TO	SIZE	PUT IN	PULLED OUT
Elgin-Hoover	No Porosity	4107	4117	8-5/8"	1388'	0
Toronto	No Porosity	4286-	4300	5-1/2"	5591'	4784'
Lansing	Water	4485	4795			
Marmaton	Water	5060	5225			
Cherokee	No Porosity	5225	5370			
Morrow	No Add. Porosity	5373	5485			
Chester	No Porosity	5546	-			

Describe in detail the manner in which the well was plugged, indicating where the mud fluid was placed and the method or methods used in introducing it into the hole. If cement or other plugs were used, state the character of same and depth placed, from feet to feet for each plug set.

Lillard Casing Pullers moved in and spotted 35 sacks cement plug 5000' to perf at 5415'. Final pump pressure 2100 psi. Displaced cement down casing with 120 barrels drilling mud. Worked 5-1/2" casing. Shot at 4752' and came free. Spotted 50 sack cement plug 1450' to 1350'. Pulled total of 149 joints of 5-1/2" casing (4784' overall measurement). Set 10 sack cement plug from 33' to 3'. Welded on steel plate 3' below ground level.

RECEIVED
STATE CORPORATION COMMISSION

MAR 10 1977

CONSERVATION DIVISION
Wichita, Kansas

(If additional description is necessary, use BACK of this sheet)

Name of Plugging Contractor Lillard Casing Pulling Inc.
Address Post Office Box 962, Woodward, Oklahoma 73801

STATE OF Oklahoma, COUNTY OF Cleveland, ss.
Larry E. Gateley (employee of owner) or (owner or operator) of the above-described well, being first duly sworn on oath, says: That I have knowledge of the facts, statements, and matters herein contained and the log of the above-described well as filed and that the same are true and correct. So help me God.

(Signature) Larry E. Gateley

J. M. Huber Corp., 2450 Liberty Twr., Okla. City, Okla. 73102 (Address)

SUBSCRIBED AND SWORN to before me this 8th day of March, 19 77

My Commission Expires Oct. 28, 1978

My commission expires

Betty J. Twist
Betty J. Twist
Notary Public.