


Give All Information Completely  
Make Required Affidavit  
Mail or Deliver Report to:  
Conservation Division  
State Corporation Commission  
212 North Market, Insurance Bldg.  
Wichita, Kansas

15-025-10125-00-00  
**WELL PLUGGING RECORD**

Clark County, Sec. 20 Twp. 24S Rge. (E) 21 (W)

Location as "NE/CNW/SW" or footage from lines C SE NE  
Lease Owner Sunray Mid-Continent Oil Company  
Lease Name Melville Harper Estate Well No. 1  
Office Address 321 West Douglas  
Character of Well (completed as Oil, Gas or Dry Hole) Dry Hole  
Date well completed January 9, 19 60  
Application for plugging filed February 22, 19 60  
Application for plugging approved February 23, 19 60  
Plugging commenced February 15, 19 60  
Plugging completed February 16, 19 60  
Reason for abandonment of well or producing formation Dry hole

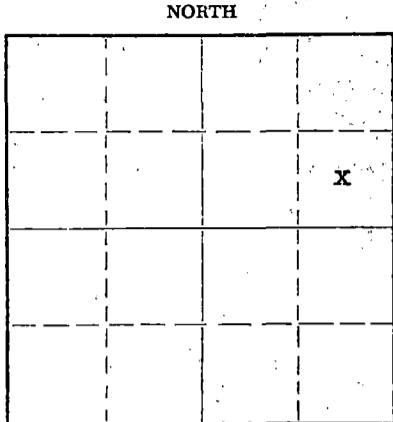

Locate well correctly on above Section Plat

If a producing well is abandoned, date of last production ----- 19 \_\_\_\_  
Was permission obtained from the Conservation Division or its agents before plugging was commenced? Yes

Name of Conservation Agent who supervised plugging of this well W. L. Lackamp  
Producing formation ----- Depth to top ----- Bottom ----- Total Depth of Well 5546 Feet  
Show depth and thickness of all water, oil and gas formations.

**OIL, GAS OR WATER RECORDS**

**CASING RECORD**

FORMATION	CONTENT	FROM	TO	SIZE	PUT IN	PULLED OUT
Morrow "A"	Water	5392	5398	20"	75'	0
Morrow "B"	Dry	5405	5412	8-5/8"	1572'	0
Morrow "C"	Dry	5412	5420	4-1/2"	5539'	5001'

Describe in detail the manner in which the well was plugged, indicating where the mud fluid was placed and the method or methods used in introducing it into the hole. If cement or other plugs were used, state the character of same and depth placed, from \_\_\_\_\_ feet to \_\_\_\_\_ feet for each plug set.

- (1) 5 sack cement plug at 5125-5300
  - (2) 18 sack cement plug at 500-550
  - (3) 40 sack cement plug from 40' to surface
  - (4) Steel plate welded on top of surface pipe.
- Hole was filled with mud.

STATE CORPORATION COMMISSION

FEB 29 1960

CONSERVATION DIVISION  
Wichita, Kansas

(If additional description is necessary, use BACK of this sheet)

Name of Plugging Contractor Toland & Reeves  
Address Box 4336 - Oklahoma City, Oklahoma

STATE OF Kansas, COUNTY OF Sedgwick, ss.

Nash A. Gough (employee of owner) or (~~owner or operator~~) of the above-described well, being first duly sworn on oath, says: That I have knowledge of the facts, statements, and matters herein contained and the log of the above-described well as filed and that the same are true and correct. So help me God.

(Signature) Nash A. Gough  
321 West Douglas, Wichita, Kansas  
(Address)

SUBSCRIBED AND SWORN TO before me this 26 day of February, 1960

My commission expires July 13, 1963 Notary Public.



15-025-10125-00-00

Sunray Mid-Continent Oil Company  
Tulsa, Oklahoma

Tulsa, Oklahoma  
December 28, 1959

CONTRACTOR: Stickle Drilling Company  
Drilling Commenced: December 3, 1959  
Drilling Completed: December 23, 1959

Melville Harper Estate #1  
Sec. 20-34S-21W, Clark  
County, Kansas.

DRILLERS LOG

Total Depth Figures Indicate Base Of Formation:

Surface	0
Sand	170
Red Bed & Shells	575
Red Bed	975
Red Bed, Shale & Shells	1465
Shale & Shells	2085
Shale & Lime	2270
Lime & Shale	3190
Shale & Lime	3445
Lime & Shale	3650
Lime	3720
Lime & Shale	3823
Lime	3910
Shale & Lime	4310
Lime & Shale	4485
Lime	4943
Lime & Shale	5003
Lime	5249
Lime & Shale	5416
Sand & Lime	5445
Lime & Shale	5540 TD

FEB 22 1960  
CONSERVATION DIVISION  
Wichita, Kansas

I, Fred E. Stickle hereby certify the above to be a true and complete Drillers Log of Sunray Mid-Continent Oil Company's Melville Harper Estate #1 Section 20-34S-21W, Clark County, Kansas.

*Fred E. Stickle*  
Fred E. Stickle

*Lillian T. Bonham*  
Notary Public

February 13, 1960  
My Commission Expires