


15-025-20583-00-00

STATE OF KANSAS
STATE CORPORATION COMMISSION

WELL PLUGGING RECORD

Give All Information Completely
Make Required Affidavit
Mail or Deliver Report to
Conservation Division
State Corporation Comm.
245 North Water
Wichita, KS 67202

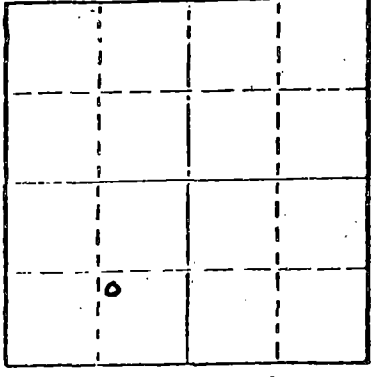

Locate well correctly on above
Section Plot

Clark County, Sec. 21 Twp. 34S Rge. 21 W
Location as "NE/CNW $\frac{1}{4}$ SW $\frac{1}{4}$ " or footage from lines
NW SE SW
Lease Owner Rine Drilling Company
Lease Name Barby Well No. 7-21
Office Address Suite 600, 300 W. Douglas, Wichita, KS 67202
Character of Well (Completed as Oil, Gas or Dry Hole)
Dry Hole
Date Well completed April 17 19 82
Application for plugging filed April 17 19 82
Application for plugging approved April 17 19 82
Plugging commenced April 17 19 82
Plugging completed April 17 19 82
Reason for abandonment of well or producing formation
Dry and Abandoned
If a producing well is abandoned, date of last production
N/A 19
Was permission obtained from the Conservation Division or
its agents before plugging was commenced? yes

Name of Conservation Agent who supervised plugging of this well Paul Luthi
Producing formation N/A Depth to top N/A Bottom N/A Total Depth of Well
Show depth and thickness of all water, oil and gas formations.

RTD 4,320'

OIL, GAS OR WATER RECORDS

CASING RECORD

FORMATION	CONTENT	FROM	TO	SIZE	PUT IN	PULLED OUT
Conductor		0	105'	20"	yes	no
Surface		0	345'	13 3/8"	yes	no
Intermediate		0	858'	8 5/8"	yes	no

Describe in detail the manner in which the well was plugged, indicating where the mud fluid was placed and the method or methods used in introducing it into the hold. If cement or other plugs were used, state the character of same and depth placed, from feet to feet for each plug set.

1200' - 70 sacks
800' - 35 sacks
40' - 10 sacks
Rathole 10 sacks
Mousehole - 5 sacks
Job Completed @ 4:00 a.m. 4/17/82

(If additional description is necessary, use BACK of this sheet)

Name of Plugging Contractor R & G Drilling Company

STATE OF KANSAS COUNTY OF SEDGWICK, ss.
E. J. RINE (employee of owner) or (owner or operator)
of the above-described well, being first duly sworn on oath, says: That I have knowledge of the facts, statements, and matters herein contained and the log of the above-described well as filed and that the same are true and correct. So help me God.

(Signature) E. J. Rine
Suite 600, 300 W. Douglas, Wichita, KS 67202
(Address)

SUBSCRIBED AND SWORN TO before me this 6th day of July, 1982.
My commission expires January 21, 1985



Donna K. McKee
Notary Public.

RECEIVED
STATE CORPORATION COMMISSION
JUL - 7 1982
CONSERVATION DIVISION
Wichita, Kansas

RECEIVED
STATE CORPORATION COMMISSION
JUL - 7 1982
CONSERVATION DIVISION
Wichita, Kansas