

15-191-00615-00-00

STATE OF KANSAS  
STATE CORPORATION COMMISSION

WELL PLUGGING RECORD

Give All Information Completely  
Make Required Affidavit  
Mail or Deliver Report to:  
Conservation Division  
State Corporation Commission  
800 Bittling Building  
Wichita, Kansas

Sumner County. Sec. 5 Twp. 30 Rge. 1 (E) (W)

Location as "NE/CNW/SW" or footage from lines NE NE NE

Lease Owner Sun Oil Company

Lease Name Matthews Well No. 1

Office Address Box 1348, Tulsa, Oklahoma

Character of Well (completed as Oil, Gas or Dry Hole) dryhole

Date well completed May 28 19 54

Application for plugging filed May 28 19 54

Application for plugging approved May 28 19 54


Plugging commenced May 28 19 54

Plugging completed May 29 19 54

Reason for abandonment of well or producing formation Dryhole

If a producing well is abandoned, date of last production \_\_\_\_\_ 19 \_\_\_\_\_

Was permission obtained from the Conservation Division or its agents before plugging was commenced? yes

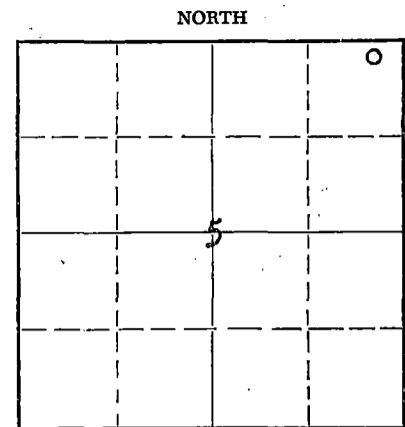

Locate well correctly on above Section Flat

Name of Conservation Agent who supervised plugging of this well W.G. Buffington, R.R. 2, Gevda Springs, Kans.

Producing formation None Depth to top \_\_\_\_\_ Bottom \_\_\_\_\_ Total Depth of Well 4077 Feet

Show depth and thickness of all water, oil and gas formations.

OIL, GAS OR WATER RECORDS

CASING RECORD

FORMATION	CONTENT	FROM	TO	SIZE	PUT IN	PULLED OUT
No formations tested				10-3/4"	350.77'	None

Describe in detail the manner in which the well was plugged, indicating where the mud fluid was placed and the method or methods used in introducing it into the hole. If cement or other plugs were used, state the character of same and depth placed, from \_\_\_\_\_ feet to \_\_\_\_\_ feet for each plug set.

Hole filled with heavy rotary mud. Spotted 15 sacks cement from 333' to 362' in surface pipe. Bailed mud from top of surface pipe and cemented top 20' with 10 sacks cement.

(If additional description is necessary, use BACK of this sheet)

Name of Plugging Contractor Anschutz Drilling Co., Inc.  
Address 709 National Bank Bldg., Wichita, Kansas.

STATE OF \_\_\_\_\_, COUNTY OF \_\_\_\_\_, ss.

\_\_\_\_\_ (employee of owner) or (owner or operator) of the above-described well, being first duly sworn on oath, says: That I have knowledge of the facts, statements, and matters herein contained and the log of the above-described well as filed and that the same are true and correct. So help me God.

(Signature) [Signature]  
H. Allen  
Box 1348, Tulsa, Oklahoma  
(Address)

SUBSCRIBED AND SWORN to before me this 3rd day of June, 19 54

My commission expires 5-9-55

24-7368-5 3-53-20M

PLUGGING  
FILE SEC 5 T 30 R 1W  
BOOK PAGE 39 LINE 4

RECEIVED  
STATE CORPORATION COMMISSION  
JUN 5 - 1954  
CONSERVATION DIVISION  
Wichita, Kansas

15-191-00615-00-00

DRILLERS' LOG

SUN OIL COMPANY  
No. 1 Matthews  
NE/4 NE/4 NE/4  
Sec. 5, Twp. 30S, Rge. 1W  
Sumner County, Kansas

	<u>From</u>	<u>To</u>
Sand, shale, gravel	0	260
Shale, lime	260	365
Lime	365	500
Shale, lime	500	1635
Broken shale, lime	1635	2566
Sand, shale	2566	2865
Shale	2865	2914
Lime (Kansas City)	2914	3135
Shale	3135	3214
Broken lime, shale	3214	3564
Lime (Miss.)	3564	3870
Shale	3870	3966
Sand (Simpson)	3966	4006
Broken sand, shale	4006	4064
Lime (Arbuckle)	4064	4077

Elev. D.F. 1251'; Grd. 1244 $\frac{1}{2}$ '

Drilling Commenced: 5-12-54

Drilling Completed: 5-28-54

Dryhole

CASING RECORD:

10-3/4" 32.75# H40 casing set at  
362.27' and cemented with 350 sax  
regular cement

CORES: None

Drill stem tests: None

I hereby certify that the foregoing is a true and correct copy of the  
Matthews No. 1 Well Log as recorded on the books of Sun Oil Company,  
Tulsa, Oklahoma.

J. H. Allen  
J. H. Allen

STATE OF OKLAHOMA )  
                          ) SS  
COUNTY OF TULSA   )

Subscribed and sworn to before me this 2nd day of June, 1954.

Francis F. Smith  
Notary Public

My Commission Expires:

May 9, 1955

PLUGGING  
FILE SEC 5 T 30 R 1W  
BOOK PAGE 37 LINE 4

RECEIVED  
STATE COMMISSION  
JUN 11 1954  
CONSERVATION DIVISION  
Wichita, Kansas