




Give All Information Completely  
Make Required Affidavit  
Mail or Deliver Report to:  
Conservation Division  
State Corporation Commission  
212 No. Market  
Wichita, Kansas

WELL PLUGGING RECORD

NORTH

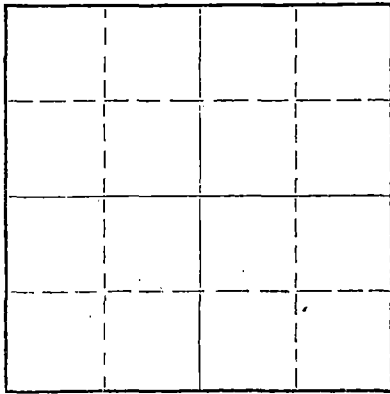

Locate well correctly on above  
Section Plat

Sumner County, Sec. 8 Twp. 30 Rge. 1 ~~(E)~~ W (W)

Location as "NE/CNW/SW" or footage from lines **NW SE SE**  
Lease Owner **Donald C. Slawson**  
Lease Name **Voils 'A'** Well No. **1**  
Office Address **408 One Twenty Bldg. Wichita, Kansas**  
Character of Well (completed as Oil, Gas or Dry Hole) **Oil**  
Date well completed **July 17** 19 **69**  
Application for plugging filed 19  
Application for plugging approved 19  
Plugging commenced **December 3** 19 **69**  
Plugging completed **December 6** 19 **69**  
Reason for abandonment of well or producing formation **Dry**

If a producing well is abandoned, date of last production 19  
Was permission obtained from the Conservation Division or its agents before plugging was commenced? **Yes**

Name of Conservation Agent who supervised plugging of this well **Howard Hess**  
Producing formation \_\_\_\_\_ Depth to top \_\_\_\_\_ Bottom \_\_\_\_\_ Total Depth of Well **3630** Feet  
Show depth and thickness of all water, oil and gas formations.

OIL, GAS OR WATER RECORDS

CASING RECORD

FORMATION	CONTENT	FROM	TO	SIZE	PUT IN	PULLED OUT
				4 1/2"	3629'	2526'

Describe in detail the manner in which the well was plugged, indicating where the mud fluid was placed and the method or methods used in introducing it into the hole. If cement or other plugs were used, state the character of same and depth placed, from \_\_\_\_\_ feet to \_\_\_\_\_ feet for each plug set.

**Johnson plug at 3550 ft. Filled with sand and 4 sacks of cement to 3500 ft. Filled with mud to 250 ft. Set rock Bridge to 230 ft. Dumped 25 sacks of cement. Filled with mud to rock to 30 ft. Dumped 10 sacks of cement.**

RECEIVED  
STATE CORPORATION COMMISSION  
DEC 11 1969  
CONSERVATION DIVISION  
Wichita, Kansas

(If additional description is necessary, use BACK of this sheet)  
Name of Plugging Contractor **Flowers Well Servicing, Inc.**  
Address **P.O. Box 122, Peabody, Kansas 66866**

STATE OF **Kansas**, COUNTY OF **Marion**, ss.  
**Douglas G. Porter** (employee or owner or operator)

well, being first duly sworn on oath, says: That I have knowledge of the facts, statements, and matters herein contained and the log of the above-described well as filed and that the same are true and correct. So help me God.

(Signature)   
Peabody, Kansas **66866**  
(Address)

SUBSCRIBED AND SWORN TO before me this **9th** day of **December**, 19 **69**

My commission expires **March 10, 1973**

W. E. Avery Notary Public.

15-191-20144-00-00

RECEIVED  
STATE CORPORATION COMMISSION

R

DEC 10 1969

CONSERVATION DIVISION  
Wichita, Kansas

DRILLERS LOG

VOILS "A" NO. 1

CASING RECORD:	OPERATOR:	Slawson Drilling Co., Inc.	DESCRIPTION:
8-5/8" @ 377' w/250 sax cement	CONTRACTOR:	Sage Drilling Co., Inc.	NW SE SE Sec. 8-30S-1W Sumner County, Kansas
TOTAL DEPTH: 3630'	COMMENCED:	June 19, 1969	
	COMPLETED:	June 27, 1969	

<u>FORMATION</u>	<u>FROM</u>	<u>TO</u>	<u>REMARKS</u>
Surface Soil	0	378	
Shale, Shells & Sand	378	1295	
Lime & Shale	1295	3537	
Lime	3537	3630	5 1/2" @ 3630' w/100 sax

I certify that this is a true and correct copy of the above log to the best of my knowledge.

SAGE DRILLING CO., INC.

By Wayne W. Kahmeyer  
Wayne W. Kahmeyer



Subscribed and sworn to before me this 30th day of June, 1969.

Louise K. Whitted  
Louise K. Whitted, Notary Public

My commission expires:  
November 26, 1970.