
15-191-01450-00-00

STATE OF KANSAS
STATE CORPORATION COMMISSION

Give All Information Completely
Make Required Affidavit
Mail or Deliver Report to:
Conservation Division
State Corporation Commission
211 No. Broadway
Wichita, Kansas

WELL PLUGGING RECORD

NORTH

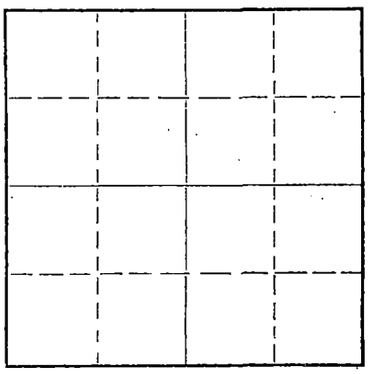

Locate well correctly on above Section Plat

Sumner County. Sec. 8 Twp. 30 Rge. ~~(E)~~ (W) 1

Location as "NE/CNW¼SW¼" or footage from lines SE SE SE

Lease Owner Fred Nixon

Lease Name Ballard Well No. 1

Office Address 144 Lochinvar Wichita, Kansas

Character of Well (completed as Oil, Gas or Dry Hole) dry hole

Date well completed January 17 19 59

Application for plugging filed January 17 19 59

Application for plugging approved January 17 19 59

Plugging commenced January 17 19 59

Plugging completed January 17 19 59

Reason for abandonment of well or producing formation dry hole

If a producing well is abandoned, date of last production 19

Was permission obtained from the Conservation Division or its agents before plugging was commenced? yes

Name of Conservation Agent who supervised plugging of this well Eugene Graham

Producing formation Depth to top Bottom Total Depth of Well 3605 Feet

Show depth and thickness of all water, oil and gas formations.

OIL, GAS OR WATER RECORDS — CASING RECORD

FORMATION	CONTENT	FROM	TO	SIZE	PUT IN	PULLED OUT
				8 5/8	375	none

Describe in detail the manner in which the well was plugged, indicating where the mud fluid was placed and the method or methods used in introducing it into the hole. If cement or other plugs were used, state the character of same and depth placed, from feet to feet for each plug set.

Hole filled with heavy rotary mud to 240 ft. Wooden bridge at 240 ft. with hulls and 15 sacks cement on bridge. Hole filled with heavy rotary mud to 30 ft. Wooden bridge at 30 ft. with hulls and 8 sacks cement on bridge. Rat hole filled with mud and capped with 2 sacks cement.

RECEIVED
STATE CORPORATION COMMISSION
JAN 27 1959
CONSERVATION DIVISION
Wichita, Kansas

(If additional description is necessary, use BACK of this sheet)

Name of Plugging Contractor White & Ellis Drilling, Inc. - License #209

Address Box 448 El Dorado, Kansas

STATE OF Kansas, COUNTY OF Butler, ss.

Dale R. Daniel, employee of contractor ~~(employee of owner)~~ or ~~(owner or operator)~~ of the above-described well, being first duly sworn on oath, says: That I have knowledge of the facts, statements, and matters herein contained and the log of the above-described well as filed and that the same are true and correct. So help me God.

(Signature) Dale R. Daniel

Box 448 El Dorado, Kansas
(Address)

SUBSCRIBED AND SWORN TO before me this 20 day of January, 19 59

Ernest Gifford
Notary Public.

My commission expires May 21, 1960

PLUGGING
FILE SEC 8 T 30 R 1W
BOOK PAGE 13 LINE 22

5441

15-191-01450-00-00

COPY


WELL LOG BUREAU—KANSAS GEOLOGICAL SOCIETY
508 East Murdock, Wichita, Kansas

Company. FRED NIXON
Farm. Ballard No. 1

SEC. 8 T. 30 R. 1W
SE SE SE

Total Depth. 3605'
Comm. 12-29-58 Comp. 1-18-59
Shot or Treated.
Contractor. White & Ellis Drlg.
Issued. 8-26-61

County Sumner
KANSAS

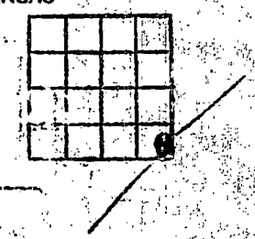

CASING:
8 5/8" 375' cem w/275 sx.

Elevation. 1257'

Production. Dry

Figures Indicate Bottom of Formations.

soil	20
shale, sandy	45
shale & lime strks	170
Anhydrite & shale, salty	300
shale, salt & Anhydrite	346
Anhydrite	378
lime	385
shale	392
lime & shale strks	710
lime	765
lime & shale strks	855
red rock	875
shale	920
lime & shale strks	1250
shale & lime	1440
shale & shells	1580
lime & shale	1610
shale & lime	1795
lime & shale strks	1970
lime & shale	2115
lime	2135
shale & lime	2260
lime & shale	2360
shale	2551
lime	2560
sandy shale & sand	2610
sand	2679
shale & sandy shale	2860
shale	2880
show oil 2955-2963'	
lime, KC	2968
lime	3108
lime & shale	3485
lime, Miss.	3605
Total Depth	

TOPS: SCOUT	
Kansas City	2880
Base Kansas City	3099
Mississippi	3485

RECEIVED
STATE CORPORATION COMMISSION
APR 20 1966