
STATE OF KANSAS
STATE CORPORATION COMMISSION

15-191-00109-00-00

WELL PLUGGING RECORD

Give All Information Completely
Make Required Affidavit
Mail or Deliver Report to:
Conservation Division
State Corporation Commission
212 North Market, Insurance Bldg.
Wichita, Kansas

NORTH

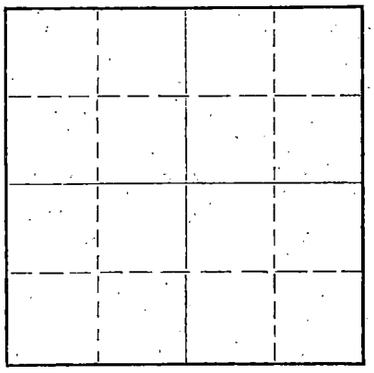

Locate well correctly on above Section Plat

Sumner County. Sec. 8 Twp. 30S Rge. ___ (E) 1/2 (W)

Location as "NE/CNW¼SW¼" or footage from lines NW-NW-SE

Lease Owner Fred Nixon

Lease Name Ballard Well No. 2

Office Address 405 First National Bank Bldg, Wichita, Kansas

Character of Well (completed as Oil, Gas or Dry Hole) Dry Hole

Date well completed November 7, 19 60

Application for plugging filed November 7, 19 60

Application for plugging approved November 7, 19 60

Plugging commenced November 7, 19 60

Plugging completed November 7, 19 60

Reason for abandonment of well or producing formation Dry Hole

If a producing well is abandoned, date of last production ___ 19___

Was permission obtained from the Conservation Division or its agents before plugging was commenced? Yes

Name of Conservation Agent who supervised plugging of this well Gene Graham

Producing formation ___ Depth to top ___ Bottom ___ Total Depth of Well 3902 Feet

Show depth and thickness of all water, oil and gas formations.

OIL, GAS OR WATER RECORDS — CASING RECORD

FORMATION	CONTENT	FROM	TO	SIZE	PUT IN	PULLED OUT
				8 5/8	375'	None

Describe in detail the manner in which the well was plugged, indicating where the mud fluid was placed and the method or methods used in introducing it into the hole. If cement or other plugs were used, state the character of same and depth placed, from ___ feet to ___ feet for each plug set.

Hole filled with heavy rotary mud to 240 feet.
Bridge at 240 feet with 20 sacks cement on bridge.
Hole filled with heavy rotary mud to 30 feet.
Bridge at 30 feet with 8 sacks cement on bridge.
Rat hole filled with heavy rotary mud and capped
with 2 sacks cement.

RECEIVED
STATE CORPORATION COMMISSION
NOV 14 1960
CONSERVATION DIVISION
Wichita, Kansas

(If additional description is necessary, use BACK of this sheet)

Name of Plugging Contractor White & Ellis Drilling, Inc. - License #209

Address Box 448 - El Dorado, Kansas

STATE OF Kansas, COUNTY OF Butler, ss.

Ernest Sifford, employee of Contractor ~~(employee of owner) or (owner or operator)~~ of the above-described well, being first duly sworn on oath, says: That I have knowledge of the facts, statements, and matters herein contained and the log of the above-described well as filed and that the same are true and correct. So help me God.

(Signature) Ernest Sifford

Box 448, El Dorado, Kansas
(Address)

SUBSCRIBED AND SWORN TO before me this 11th day of November, 19 60

L. R. Amos
Notary Public.

My commission expires September 26, 1964

5441

15-191-00109-00-00

Casing Record

8 5/8	375' Cemented w/217 sacks
T.D.	3902'

Location: NW-NW-SE,IW
Section: 8-30S-2W
Summer County, Kansas
Farm: Ballard #2
Well Owner: Fred Nixon
Contractor: White & Ellis Drlg., Inc
Started: 10/27/60
Completed: 11/7/60
Elevation: 1268 D.F. - 1270 R.B.

Kelly Bushing Measurement 5' above ground level

FORMATION	DEPTH
Soil	0-8
Soil & Shale	30
Lime	50
Shale & Lime stks.	195
Shale	300
Lime	330
Shale & Lime stks.	375
Lime & Shale stks.	1350
Shale	1555
Shale & Lime	1620
Lime w/Shale stks.	1950
Lime	2030
Lime & Shale	2096
Shale & Lime	2225
Lime & Shale	2440
Shale	2546
sdy. Shale	2580
Lime & Shale stks.	2640
Shale	2710
Shale & Lime	2729
Lime w/Shale stks.	2790
Shale	2886
Lime	3137
Lime & Shale	3189
Shale & Lime	3385
Lime & Shale	3440
Shale & Lime	3523
Lime	3828
Lime & Shale	3870
Shale & Lime stks.	3899
Sand	3902

RECEIVED
STATE CORPORATION COMMISSION
NOV 14 1960
CONSERVATION DIVISION
Wichita, Kansas

TOPS

Stafnaker	2850
Kansas City	2919
Base Kansas City	3137
Mississippi	3523
Kinderhook	3849
Simpson Sand	3899

Dry Hole
Plugged & Abandoned