


STATE OF KANSAS  
STATE CORPORATION COMMISSION  
200 Colorado Derby Bldg.  
Wichita, Kansas 67202

Form CP-4  
Rev. 12-15-80

WELL PLUGGING RECORD

Give All Information Completely  
Make Required Affidavit.

COUNTY Clark SEC. 22 TWP. 34S RGE. 21 ~~EX~~W  
Location as in quarters or footage from lines:  
C NW SW

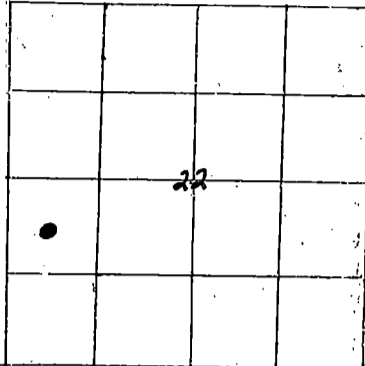

Locate Well  
correctly on above  
Section Platt.

Lease Owner Rine Drilling Company  
Lease Name Barby-Harper Well No. 1-22  
Office Address Suite 600, 300 W. Douglas, Wichita, KS 67202  
Character of Well (Completed as Oil, Gas or Dry Hole): Oil  
Date Well Completed February 9, 1981  
Application for plugging filed January 8, 1982  
Plugging commenced January 8, 1982  
Plugging completed January 8, 1982  
Reason for abandonment of well or producing formation  
Water invasion from lower formations  
Was permission obtained from the Conservation Division or it's  
Agent's before plugging was commenced? yes

Name of Conservation Agent who supervised plugging of this well Paul Luthi - Minneola, KS  
Producing formation Toronto Depth to top 4266 bottom 4276 T.D. 5421'  
Show depth and thickness of all water, oil and gas formations.

OIL, GAS OR WATER RECORDS

Casing Record

Formation	Content	From	To	Size	Put in	Pulled Out
	Surface	0	700'	8 5/8	N/A	N/A
	Production	0	4276'	5 1/2		1,860'

Describe in detail the manner in which the well was plugged, indicating where the mud fluid was placed and the method or methods used in introducing it into the hold. If cement or other plugs were used, state the character of same and depth placed, from \_\_\_\_\_ feet to \_\_\_\_\_ feet for each plug set.

1st plug @ 700' with 50 sacks common, 5 sx hulls, 5 sx gel.  
2nd plug @ 40'-0' with 10 sacks common

Job completed January 8, 1982  
Plug down at 5:30 p.m.

(If additional description is necessary, use BACK of this sheet)

Name of Plugging Contractor Arapaho Well Service, Inc.

STATE OF KANSAS COUNTY OF SEDGWICK, ss.

E. J. Rine (~~employee of owner~~) or (owner or operator) of the above-described well, being first duly sworn on oath, says: That I have knowledge of the facts, statements, and matters herein contained and the log of the above-described well as filed and that the same are true and correct. So help me God.

(Signature) E. J. Rine  
Suite 600, 300 W. Douglas, Wichita, KS  
(Address)

SUBSCRIBED AND SWORN TO before me this 18th day of January, 19 82



Donna K. McKee Notary Public.  
STATE CORPORATION COMMISSION

**JAN 19 1982**  
CONSERVATION DIVISION  
Wichita, Kansas