

15-025-00028-0000

STATE OF KANSAS
STATE CORPORATION COMMISSION


WELL PLUGGING RECORD

Give All Information Completely
Make Required Affidavit
Mail or Deliver Report to:
Conservation Division
State Corporation Commission
211 No. Broadway
Wichita, Kansas

Clark County, Sec. 1 Twp. 34S Rge. (E) 21 (W)

Location as "NE/CNW/SW" or footage from lines. 100' W of CNW SW
Lease Owner Tennessee Gas Transmission Company
Lease Name C.J. Knor Well No. 1
Office Address P.O. Box 513 Chase Kansas
Character of Well (completed as Oil, Gas or Dry Hole) Dry Hole
Date well completed Aug. 10 19 56
Application for plugging filed Written - Aug. 15 19 56
Application for plugging approved Oral - Aug. 10 19 56
Plugging commenced Aug. 10 19 56
Plugging completed Aug. 10 19 56
Reason for abandonment of well or producing formation

NORTH

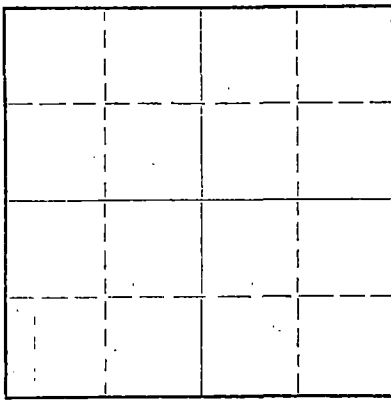

Locate well correctly on above
Section Plat

If a producing well is abandoned, date of last production 19
Was permission obtained from the Conservation Division or its agents before plugging was commenced? Yes

Name of Conservation Agent who supervised plugging of this well M.A. Rives
Producing formation Depth to top Bottom Total Depth of Well 5650 Feet
Show depth and thickness of all water, oil and gas formations.

OIL, GAS OR WATER RECORDS

CASING RECORD

FORMATION	CONTENT	FROM	TO	SIZE	PUT IN	PULLED OUT
				20"OD	119	None
				13 3/8"OD	540	None

Describe in detail the manner in which the well was plugged, indicating where the mud fluid was placed and the method or methods used in introducing it into the hole. If cement or other plugs were used, state the character of same and depth placed, from feet to feet for each plug set.

Heavy mud TD 5650' to 520'
Set plug at 520'
35 sax cement on top of plug,
Heavy mud to 45'
Set plug at 45' and
30 sax cement to cellar.

Plugging Completed 6:00 PM 8-10-56

(If additional description is necessary, use BACK of this sheet)

Name of Plugging Contractor Group Exploration Company
Address Sterling Kansas

STATE OF Kansas, COUNTY OF Rice, ss.
Paul H. Lenhart (employee of owner) of (owner/operator) of the above-described

well, being first duly sworn on oath, says: That I have knowledge of the facts, statements, and matters herein contained and the log of the above-described well as filed and that the same are true and correct. So help me God.

(Signature) Paul H. Lenhart

P.O. Box 513 Chase Kansas
(Address)

SUBSCRIBED AND SWORN to before me this 15 day of August, 1956

Vincent O. Gray Notary Public.

My commission expires May 20 1958

PLUGGING
FILE SEC 1 T 34 R 21 W
BOOK PAGE 88 LINE 39

RECEIVED
STATE CORPORATION COMMISSION
AUG 16 1956
CONSERVATION DIVISION

GROUP EXPLORATION COMPANY
Sterling, Kansas

WELL LOG-----C. J. KNOP #1

Location: C NW SW, Section 1-34S-21W,
Clark County, Kansas

OWNER: Tennessee Gas Transmission Company
ROTARY DRILLING CONTRACTOR: Group Exploration Company

COMMENCED: 6-29-56 (w.r.)
COMPLETED: 8-10-56 (w.r.)

TOTAL DEPTH: 5650'

LOG

0-125	Shale & Shells
125-175	Shale, Sand & Gyp
175-550	Shale & Gyp
550-580	Shale
580-975	Salt & Gyp
975-1085	Red Bed & Gyp
1085-1850	Shale & Shells
1850-2415	Shale & Limestone
2415-2985	Limestone
2985-3575	Limestone & Shale
3575-3655	Limestone
3655-3735	Limestone & Shale
3735-3790	Limestone
3790-3928	Limestone & Shale
3928-3980	Limestone
3980-4015	Shale
4015-4125	Limestone & Shale
4125-4280	Shale
4280-4465	Limestone & Shale
4465-4530	Shale
4530-4955	Limestone
4955-5015	Limestone & Shale
5015-5095	Limestone
5095-5155	Limestone & Shale
5155-5263	Limestone
5263-5375	Limestone & Shale
5375-5480	Coring
5480-5650	Limestone T.D.

CASING RECORD

Set 20" casing at 121' with 350 sacks cement, 2% calcium chloride.

Set 13-3/8" casing at 560' with 450 sacks cement.

PRODUCTION

Plugged & Abandoned

RECEIVED
STATE OF KANSAS
AUG 31 1956
CONSERVATION DIVISION
Wichita, Kansas

PLUGGING
FILE SEC. 1 T. 34 R. 21W
BOOK PAGE 88 LINE 39


15-025-00028-00-00
 WELL LOG BUREAU—KANSAS GEOLOGICAL SOCIETY
 508 East Murdock, Wichita, Kansas

Company. TENNESSEE GAS TRANSMISSION
 Farm. C. J. Knop No. 1

SEC. 1 T. 34 R. 21W
 C NW SW

Total Depth. 5650'
 Comm. 6-29-56 Comp. 8-10-56
 Shot or Treated.
 Contractor. Group Exploration Co.
 Issued. 9-29-56

County Clark
 KANSAS

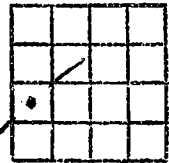

Elevation. 1875'

Production. Dry

CASING:

20" 121' w/350 sx cem.
 13 3/8" 560' w/450 sx cem.

Figures indicate Bottom of Formations.

shale-shells	125
shale-sand-gyp	175
shale-gyp	550
shale	580
salt-gyp	975
red bed-gyp	1085
shale-shells	1850
shale-limestone	2415
limestone	2985
limestone-shale	3575
limestone	3655
limestone-shale	3735
limestone	3790
limestone-shale	3928
limestone	3980
shale	4015
limestone-shale	4125
shale	4280
limestone-shale	4465
shale	4530
limestone	4955
limestone-shale	5015
limestone	5095
limestone-shale	5155
limestone	5263
limestone-shale	5375
Coring	5375- 5480
limestone	5650
Total Depth	

TOPS:

Lansing-Kansas City	4526
B/Kansas City=	4914
Marmaton	5092
Cherokee	5251
Morrow	5368
Mississippi	5439
St. Gen	5552

DST #1 - 5230-63, open 1 hr.,
 rec. 8' mud, 70-50# BHP,
 I 7 FFP 50.

DST #2 - 5367½-5437½, open 1 hr.,
 very wk blow, died in 5", rec.
 20' drilling mud.

DST #3 - 5500-5550, SI 30",
 open 2 hrs., rec. fair blow,
 rec. 35' rtry mud, 290# ISIP,
 180# BHP.

FILED
 STATE CORPORATI
 DEC 28 1956
 CONSERVATION DIVISION
 Wichita, Kansas

PLUGGING
 FILE SEC 1 T. 34 R. 21W
 BOOK PAGE 47 L 41