


Give All Information Completely
Make Required Affidavit
Mail or Deliver Report to:
Conservation Division
State Corporation Commission
212 No. Market
Wichita, Kansas

WELL PLUGGING RECORD

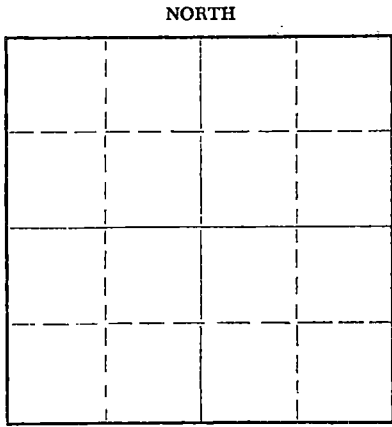

Locate well correctly on above Section Plat.

Clark County. Sec. 3 Twp. 34S Rge. (E) 21 (W)
Location as "NE/CNW/SW" or footage from lines SE/NW
Lease Owner Ashland Oil & Refining Co.
Lease Name J. C. Harper Well No. 3
Office Address Box 18695, Oklahoma City, Oklahoma
Character of Well (completed as Oil, Gas or Dry Hole) _____
Date well completed _____ 10-29 19 53
Application for plugging filed _____ 5-24 19 68
Application for plugging approved _____ 5-27 19 68
Plugging commenced _____ 6-25 19 68
Plugging completed _____ 8-8 19 68
Reason for abandonment of well or producing formation _____

If a producing well is abandoned, date of last production _____ 19 _____
Was permission obtained from the Conservation Division or its agents before plugging was commenced? yes

Name of Conservation Agent who supervised plugging of this well E. Eves
Producing formation _____ Depth to top _____ Bottom _____ Total Depth of Well _____ Feet
Show depth and thickness of all water, oil and gas formations.

OIL, GAS OR WATER RECORDS

CASING RECORD

| FORMATION | CONTENT | FROM | TO | SIZE | PUT IN | PULLED OUT |
|-----------|---------|------|----|-------|--------|------------|
| | | | | 8 5/8 | 2384 | 1244 |
| | | | | 5 1/2 | 5477 | 3740 |
| | | | | | | |
| | | | | | | |
| | | | | | | |
| | | | | | | |
| | | | | | | |

Describe in detail the manner in which the well was plugged, indicating where the mud fluid was placed and the method or methods used in introducing it into the hole. If cement or other plugs were used, state the character of same and depth placed, from _____ feet to _____ feet for each plug set.

Pumped 30 sack cement plug from 4500 to 4700 feet. Pumped hole full of mud. Shot casing from 4012 to 3735 feet. Pulled 114 jts of 5 1/2" casing. Shot 8 5/8" from 1522 to 1244 feet. Pulled 8 5/8 up to 492 feet. Pumped 50 sacks cement from 492 to 642 feet. Finished pulling 8 5/8 -- 39 jts., capped with 20 sacks cement and had plate welded on surface.

RECEIVED
STATE CORPORATION COMMISSION
SEP 3 1968
CONSERVATION DIVISION
Wichita, Kansas

(If additional description is necessary, use BACK of this sheet)
Name of Plugging Contractor Gayle E. Toland & Co.
Address Box 94336, Oklahoma City, Oklahoma 73109

STATE OF Oklahoma, COUNTY OF Oklahoma, ss.
Sid Wilson (employee of owner) or (owner or operator) of the above-described well, being first duly sworn on oath, says: That I have knowledge of the facts, statements, and matters herein contained and the log of the above-described well as filed and that the same are true and correct. So help me God.

(Signature) Sid Wilson

(Address)

SUBSCRIBED AND SWORN TO before me this 29th day of August, 19 68

Helen To Beatt

My commission expires 6-8-69

Notary Public.

15-025-10135-00-00

Jesse UNITED PRODUCING COMPANY
WENTLE C. HARPER #3
CLARK COUNTY, KANSAS
SE/4 NW/4 3-348-21W

PARKER DRILLING COMPANY

Spudded 9/30/53
Completed 10/29-53

| <u>FORMATION</u> | <u>FROM</u> | <u>TO</u> |
|---------------------|-------------|-----------|
| Red Bed | 0 | 105 |
| Red Bed and Gyp | 105 | 502 |
| Red Bed and Salt | 502 | 1118 |
| Red Bed and Shale | 1118 | 1528 |
| Red Bed and Gyp | 1528 | 2087 |
| Shale & Lime | 2087 | 2361 |
| Shale, Lime and Gyp | 2361 | 2400 |
| Shale and Lime | 2400 | 2517 |
| Lime and Sand | 2517 | 2588 |
| Lime and Shale | 2588 | 2778 |
| Lime and Sand | 2778 | 2830 |
| Lime and Shale | 2830 | 5351 |
| Lime, shale & Sand | 5351 | 5409 |
| Shale and Sand | 5409 | 5477 |

RECEIVED
STATE CORPORATION COMMISSION
MAY 27 1968
CONSERVATION DIVISION
Wichita, Kansas