


Give All Information Completely
Make Required Affidavit
Mail or Deliver Report to:
Conservation Division
State Corporation Commission
800 Biting Building
Wichita, Kansas

15-025-10138-00-00

WELL PLUGGING RECORD

NORTH

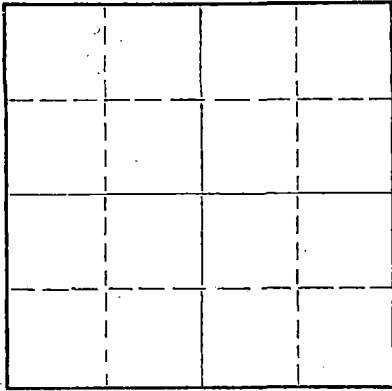

Locate well correctly on above
Section Flat

Clark County, Sec. 3 Twp. 34S Rge. (E) 21(W)
Location as "NE/CNW/SW" or footage from lines NW/NE
Lease Owner Ashland Oil & Refining Company
Lease Name J. C. Harper Well No. 6
Office Address Box 18695, Oklahoma City, Oklahoma
Character of Well (completed as Oil, Gas or Dry Hole) Oil
Date well completed 7-17 19 54
Application for plugging filed 5-24 19 68
Application for plugging approved 5-27 19 68
Plugging commenced 6-5 19 68
Plugging completed 7-2 19 68
Reason for abandonment of well or producing formation

If a producing well is abandoned, date of last production December 19 64
Was permission obtained from the Conservation Division or its agents before plugging was commenced? yes

Name of Conservation Agent who supervised plugging of this well E. Eves
Producing formation Depth to top Bottom Total Depth of Well Feet
Show depth and thickness of all water, oil and gas formations.

OIL, GAS OR WATER RECORDS

CASING RECORD

FORMATION	CONTENT	FROM	TO	SIZE	PUT IN	PULLED OUT
				8 5/8	2359	983
				5 1/2	5567	3172

Describe in detail the manner in which the well was plugged, indicating where the mud fluid was placed and the method or methods used in introducing it into the hole. If cement or other plugs were used, state the character of same and depth placed, from feet to feet for each plug set.

Pumped 25 sack plug from 5000 to 5175 feet. Pumped hole full of mud. Shot 5 1/2" from 3523 to 3138 feet. Pulled 105 joints of 5 1/2". Shot 8 5/8" from 1101 to 975 feet. Pulled 15 joints of 8 5/8". Pumped 50 sack cement plug from 400 to 550 feet. Finished pulling 8 5/8" -- 31 joints. Refilled hole with mud capped well with 20 sacks cement and had plate welded on surface.

RECEIVED
STATE CORPORATION COMMISSION
JUL 23 1968
CONSERVATION DIVISION
Wichita, Kansas

(If additional description is necessary, use BACK of this sheet)
Name of Plugging Contractor Gayle E. Toland & Co.
Address Box 94336, Oklahoma City, Oklahoma 73109

STATE OF Oklahoma, COUNTY OF Oklahoma, ss.
Sid Wilson (employee of owner) or (owner or operator) of the above-described well, being first duly sworn on oath, says: That I have knowledge of the facts, statements, and matters herein contained and the log of the above-described well as filed and that the same are true and correct. So help me God.

(Signature) Sid Wilson

(Address)

SUBSCRIBED AND SWORN TO before me this 22 day of July, 1968

Glenn Scott

My commission expires

6-8-69

Notary Public.



15-025-10138-00-00

J. C. HARPER WELL NO. 6
C NW NE SECTION 3-34S-21W
CLARK COUNTY, KANSAS
UNITED PRODUCING COMPANY, INC.

CASING RECORD:

SET 20" CSG. @ 86' CEMENTED W/250 SXS.
SET 13-3/8" CSG. @ 500' CEMENTED W/500 SXS. 5 C.C.
SET 8-5/8" CSG. @ 2340' CEMENTED W/500 SXS. 4% GEL, 250 SXS. COMMON.
SET 5-1/2" CSG. @ 5562' CEMENTED W/250 SXS. 2% GEL.

COMMENCED: 6/12/54
COMPLETED: 7/7/54

SURFACE CLAY	0	86
RED BED	86	266
RED BED AND SHALE	266	647
RED BED, SHALE AND SHELLS	647	907
SHALE AND RED BED	907	1269
LIME AND SHALE	1269	2191
LIME	2191	2192
LIME AND SHALE	2192	3920
SHALE	3920	4007
LIME AND SHALE	4007	4076
SHALE AND SANDY LIME	4076	4217
LIME AND SHALE	4217	5061
SHALE	5061	5071
SHALE AND LIME	5071	5095
LIME, SAND AND SHALE	5095	5120
LIME AND SHALE	5120	5390
SAND	5390	5395
SHALE AND SAND	5395	5421
LIME AND SHALE	5421	5495
SAND AND SHALE	5495	5519
SAND, SHALE AND LIME	5519	5582
LIME AND SHALE	5582	5592
TOTAL DEPTH		5592

RECEIVED
STATE CORPORATION COMMISSION
MAY 27 1968
CONSERVATION DIVISION
Wichita, Kansas

STATE OF OKLAHOMA)
)SS
COUNTY OF TULSA)

I HEREBY AFFIRM THAT THE ABOVE AND FOREGOING IS A TRUE AND CORRECT COPY OF THE LOG OF THE J. C. HARPER WELL NO. 6, LOCATED IN THE CENTER OF THE NORTHWEST QUARTER OF THE NORTHEAST QUARTER OF SECTION 3, TOWNSHIP 34 SOUTH, RANGE 21 WEST, CLARK COUNTY, KANSAS.

HELMERICH & PAYNE, INC.

W. T. Payne
VICE PRESIDENT

SUBSCRIBED AND SWORN TO BEFORE ME A NOTARY PUBLIC THIS 14TH DAY OF JULY, 1954.

Wanda Cowlishaw
NOTARY PUBLIC

MY COMMISSION EXPIRES JUNE 9, 1958.