


WELL PLUGGING RECORD

All information Completely  
Required Affidavit  
Deliver Report to:  
Conservation Division  
State Corporation Commission  
211 No. Broadway  
Wichita, Kansas

Clark County, Sec. 3 Twp. 34S Rge. 21 (W)

Location as "NE/CNW%SW%" or footage from lines C SE/4 SE/4  
Lease Owner United Producing Co., Inc.  
Lease Name J. C. Harper Well No. 16  
Office Address Box 949, Liberal, Kansas  
Character of Well (completed as Oil, Gas or Dry Hole) Dry Hole  
Date well completed 7-29 1955  
Application for plugging filed 10-24 1962  
Application for plugging approved 10-25 1962  
Plugging commenced 2-14 1963  
Plugging completed 2-15 1963  
Reason for abandonment of well or producing formation Dry Hole

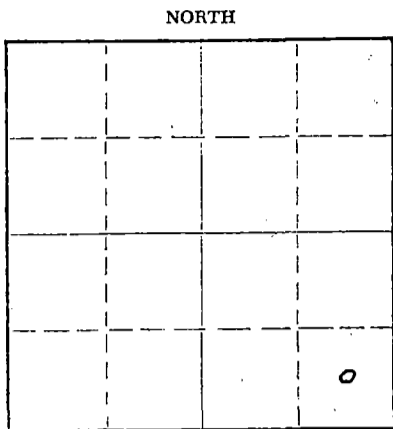

Locate well correctly on above  
Section Plat

If a producing well is abandoned, date of last production - 19-  
Was permission obtained from the Conservation Division or its agents before plugging was commenced? Yes

Name of Conservation Agent who supervised plugging of this well Hugh E. Scott  
Producing formation \_\_\_\_\_ Depth to top \_\_\_\_\_ Bottom \_\_\_\_\_ Total Depth of Well 5541 Feet  
Show depth and thickness of all water, oil and gas formations.

OIL, GAS OR WATER RECORDS

CASING RECORD

FORMATION	CONTENT	FROM	TO	SIZE	PUT IN	PULLED OUT
				13 3/8	488	None
				8 5/8	2370	None

Describe in detail the manner in which the well was plugged, indicating where the mud fluid was placed and the method or methods used in introducing it into the hole. If cement or other plugs were used, state the character of same and depth placed, from \_\_\_\_\_ feet to \_\_\_\_\_ feet for each plug set.

**Filled hole with mud from 5541' TD to 450'**  
**35 sacks cement from 450' to 350'**  
**Mud from 350' to 40'**  
**15 sacks cement from 40' to 3'**  
**Welded cap on casing 3' below surface**

FEB 20 1963

CONSERVATION DIVISION  
Wichita, Kansas

Name of Plugging Contractor United Producing Co., Inc. (Halliburton)  
Address Box 949, Liberal, Kansas

STATE OF KANSAS, COUNTY OF SEWARD, ss.  
B. W. Fuller (employee of owner) or (owner or operator) of the above-described

well, being first duly sworn on oath, says: That I have knowledge of the facts, statements, and matters herein contained and the log of the above-described well as filed and that the same are true and correct. So help me God.

(Signature) B. W. Fuller

Box 949, Liberal, Kansas  
(Address)

SUBSCRIBED AND SWORN TO before me this 19th day of February, 1963

My commission expires 6-6-66

Aue Donham  
Notary Public.

15-025-10142-00-00

J. C. HARPER NO. 16  
C SE SE SECTION 3-34S-21W  
CLARK COUNTY, KANSAS  
UNITED PRODUCING COMPANY, INC.

CASING RECORD:

SET 13-3/8" csg w/500 SKS & 5 SKS OF CC  
SET 8-5/8" csg w/500 SKS, 4% 200 SKS CC

COMMENCED: 7/3/55  
COMPLETED: 7/31/55

SURFACE SOIL, CLAY ROCK	0 - 45
ROCK SAND & CLAY	45 - 53
SURFACE CLAY	53 - 75
SURFACE	75 - 198
RED BED	198 - 500
SHALE	500 - 618
RED BED & SHALE	618 - 863
SHALE & SHELLS	863 - 965
SHALE	965 - 1441
SHALE, ANHYDRITE & SHELLS	1441 - 1548
SHALE & ANHYDRITE	1548 - 2375
ANHYDRITE & LIME	2375 - 2510
SHALE & LIME	2510 - 4425
LIME	4425 - 4475
LIME & SHALE	4475 - 4591
BROKEN LIME & SHALE	4591 - 4660
LIME & SHALE	4660 - 4700
LIME CHALKY AND HARD LIME	4700 - 4792
LIME	4792 - 4800
LIME & SOME SHALE	4800 - 4850
LIME & CHERTY LIME	4850 - 4900
LIME & SHALE	4900 - 4915
LIME	4915 - 4951
SHALE & LIME	4951 - 5265
LIME	5265 - 5318
SHALE & LIME	5318 - 5458
SHALE, LIME & SAND	5458 - 5524
SANDY LIME & SHALE	5524 - 5545
<b>TOTAL</b>	<b>5545</b>

**RECEIVED**  
STATE CORPORATION COMMISSION  
OCT 29 1962  
CONSERVATION DIVISION  
Wichita, Kansas

STATE OF OKLAHOMA )  
                                  )SS  
COUNTY OF TULSA   )

I HEREBY AFFIRM THAT THE ABOVE AND FOREGOING IS A TRUE AND CORRECT COPY OF THE LOG OF THE J. C. HARPER NO. 16 WELL, LOCATED IN THE C SE SE SECTION 3-34S-21W, CLARK COUNTY, KANSAS.

HELMERICH & PAYNE, INC.

*[Signature]*  
VICE PRESIDENT

SUBSCRIBED AND SWORN TO BEFORE ME A NOTARY PUBLIC THIS 16TH DAY OF AUGUST, 1955.

*[Signature]*  
NOTARY PUBLIC

MY COMMISSION EXPIRES:  
JUNE 20, 1959