

15-025-10096-00-00

STATE OF KANSAS  
STATE CORPORATION COMMISSION


Form CP-4

Give All Information Completely  
Make Required Affidavit  
Mail or Deliver Report to:  
Conservation Division  
State Corporation Commission  
P. O. Box 17027  
Wichita, Kansas 67217  
NORTH

WELL PLUGGING RECORD

Clark County, Sec. 5 Twp. 34S Rge. (21) 21 (W)

Location as "NE/CNW/SW" or footage from lines SW NE  
Lease Owner A.L. Abercrombie, Inc.  
Lease Name HARPER Well No. 1-5  
Office Address 801 Union Center, Wichita, Kansas 67202  
Character of Well (completed as Oil, Gas or Dry Hole) Gas Unit  
Date well completed March 23 1960  
Application for plugging filed January 17 1975  
Application for plugging approved January 18 1975  
Plugging commenced January 24 1975  
Plugging completed January 29 1975  
Reason for abandonment of well or producing formation Depleted

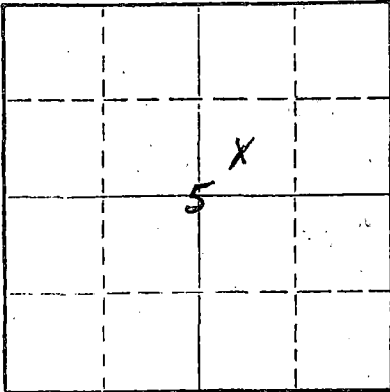

Locate well correctly on above Section Plat

If a producing well is abandoned, date of last production May 19 74  
Was permission obtained from the Conservation Division or its agents before plugging was commenced? Yes

Name of Conservation Agent who supervised plugging of this well Clarence Thomas  
Producing formation \_\_\_\_\_ Depth to top \_\_\_\_\_ Bottom \_\_\_\_\_ Total Depth of Well 5665 Feet  
Show depth and thickness of all water, oil and gas formations.

OIL, GAS OR WATER RECORDS

CASING RECORD

FORMATION	CONTENT	FROM	TO	SIZE	PUT IN	PULLED OUT
				13 3/8"	1315'	None
				8-5/8"	639'	None
				5-1/2"	5619'	4400'

Describe in detail the manner in which the well was plugged, indicating where the mud fluid was placed and the method or methods used in introducing it into the hole. If cement or other plugs were used, state the character of same and depth placed, from \_\_\_\_\_ feet to \_\_\_\_\_ feet for each plug set.

Pump 35 sks. of cement @ 5512' to 5400'  
Pump 50 sks. of cement @ 700' to 550'  
Put 10 sks. of cement @ 35' to Surface

RECEIVED  
STATE CORPORATION COMMISSION

FEB 10 1975

CONSERVATION DIVISION  
Wichita, Kansas


(If additional description is necessary, use BACK of this sheet)

Name of Plugging Contractor Sargents Casing Pulling Service Ks. No. 511  
Address Liberal, Kansas 67901

STATE OF KANSAS COUNTY OF SEDGWICK  
Jerry A. Langrehr, Exec. V.P. (employee of owner) or (owner or operator) of the above-described well, being first duly sworn on oath, says: That I have knowledge of the facts, statements, and matters herein contained and the log of the above-described well as filed and that the same are true and correct. So help me God.

(Signature) Jerry A. Langrehr  
801 Union Center, Wichita, Ks. 67202  
(Address)

Subscribed and sworn to before me this 7th day of February, 1975

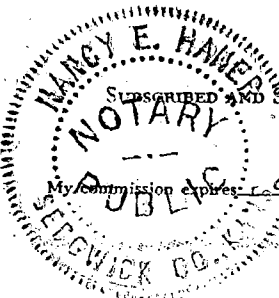

April 8, 1978

Nancy E. Hauer  
Notary Public.

15-025-10096-00-00

HARPER 1-5  
Panhandle Development Co., Inc.  
Section 5-34S-21W  
Clark County, Kansas

CASING RECORD:

Run 4 joints of 13 3/8" casing at 131.50' K. B., cemented with 175 sacks sunset cement, run 23 joints 8 5/8" used casing, set at 639.23 K.B., cemented with 175 sacks of Portland Cement with 3% C.C., run 46 joints of 5 1/2" 17# casing - 1421.73, run 129 joints of 5 1/2" 15.5# casing - 4196.49, set at 5618.72 K.B. cemented 150 sacks Pozmix

Commenced: 2-26-60  
Completed: 3-23-60

FORMATION

<u>FORMATION</u>	<u>FROM</u>	<u>TO</u>
Top Soil and Clay	0	145
Shale	145	250
Red Bed	250	1683
Anhydrite and Shale	1683	1917
Shale	1917	2340
Lime	2340	4058
Shale	4058	4265
Shale and Lime	4265	4589
Lime	4589	5298
Lime and Shale	5298	5421
Lime and Sand	5421	5465
Shale and Sand	5465	5527
Lime, Sand and Shale	5527	5585
Lime and Shale	5585	5665 RTD

**RECEIVED**  
STATE CORPORATION COMMISSION

JUN 21 1962

CONSERVATION DIVISION  
Wichita, Kansas

State of Kansas     )  
                                  ) SS  
County of Sedgwick )

I Hereby affirm that the above and foregoing is a true and correct copy of the log of the Harper 1-5 well, located C-SW-NE of Section 5-34S-21W, Clark County, Kansas.

PANHANDLE DEVELOPMENT CO., INC.

B. Lynn Harrington  
Accountant

Subscribed and sworn to before me a notary public this 20 day of June, 1962.

Leah Joyce Hefke  
Notary Public

My commission expires June 16, 1963.