

STATE CORPORATION COMMISSION OF KANSAS
OIL & GAS CONSERVATION DIVISION

WELL COMPLETION OR RECOMPLETION FORM
ACO-1 WELL HISTORY

DESCRIPTION OF WELL AND LEASE

Operator: License # 8758
Name Raw Energy Corporation
Address 7200 West 13th
Suite 8
City/State/Zip Wichita, Kansas 67212

Purchaser Colony Natural Gas
P.O. Box 50550 Midland, TX

Operator Contact Person Benny Green
Phone (316)722-6382

Contractor: License # 5879
Name J. B. Bohannon Drilling, Inc.

Wellsite Geologist Mark Rogers
Phone (316)722-6382

Designate Type of Completion
 New Well Re-Entry Workover
 Oil SWD Temp Abd
 Gas Inj Delayed Comp.
 Dry Other (Core, Water Supply etc.)

If OWWO: old well info as follows:
Operator
Well Name
Comp. Date Old Total Depth

WELL HISTORY

Drilling Method:
 Mud Rotary Air Rotary Cable
1/17/85 1/29/85 2/4/85
Spud Date Date Reached TD Completion Date
5904 5849
Total Depth PBTD

Amount of Surface Pipe Set and Cemented at 1446 feet
Multiple Stage Cementing Collar Used? Yes No
If yes, show depth set feet
If alternate 2 completion, cement circulated from feet depth to w/SX cmt

API NO. 15-119-20694-00-00

County Meade

SE NW Sec 21 Twp 33 Rge 28 East West

3150 Ft North from Southeast Corner of Section
3150 Ft West from Southeast Corner of Section
(Note: Locate well in section plat below)


Lease Name Heinson Well # 1-21

Field Name ~~Wildcat~~ Borchers

Producing Formation Morrow

Elevation: Ground 2514 KB 2526

Section Plat

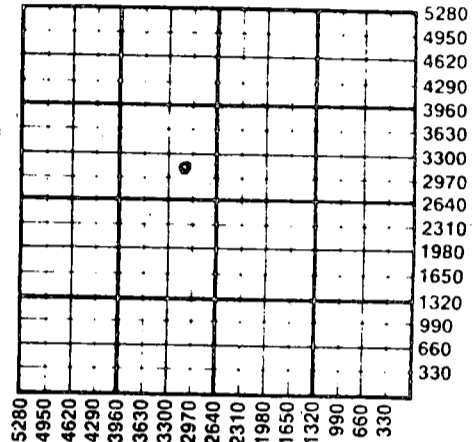

RECEIVED
STATE CORPORATION COMMISSION
FEB 15 1985

CONSERVATION DIVISION
Wichita, Kansas

WATER SUPPLY INFORMATION

Disposition of Produced Water: Disposal Repressuring
Docket #

Questions on this portion of the ACO-1 call:
Water Resources Board (913) 296-3717

Source of Water:
Division of Water Resources Permit #

Groundwater Ft North from Southeast Corner (Well) Ft West from Southeast Corner of Sec 21 Twp 33 Rge 28 East West
 Surface Water Ft North from Southeast Corner (Stream, pond etc) Ft West from Southeast Corner Sec Twp Rge East West
 Other (explain) (purchased from city, R.W.D. #)

INSTRUCTIONS: This form shall be completed in duplicate and filed with the Kansas Corporation Commission, 200 Colorado Derby Building, Wichita, Kansas 67202, within 90 days after completion or recompletion of any well. Rule 82-3-130 and 82-3-107 apply.
Information on side two of this form will be held confidential for a period of 12 months if requested in writing and submitted with the form. See rule 82-3-107 for confidentiality in excess of 12 months.
One copy of all wireline logs and drillers time log shall be attached with this form. Submit CP-4 form with all plugged wells. Submit CP-111 form with all temporarily abandoned wells.


All requirements of the statutes, rules and regulations promulgated to regulate the oil and gas industry have been fully complied with and the statements herein are complete and correct to the best of my knowledge.

Signature Benny Green

Title District Manager Date 2/14/85

Subscribed and sworn to before me this 14th day of February 1985

Notary Public Carla M. Parker

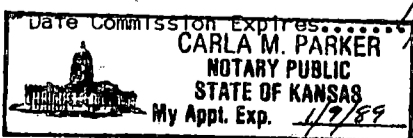

K.C.C. OFFICE USE ONLY
 Letter of Confidentiality Attached
 Wireline Log Received
 Drillers Timelog Received
Distribution:
 KCC SWD/Rep NGPA
 KGS Plug Other (Specify)

Sec 21 Twp 33 Rge 28