


STATE OF KANSAS  
STATE CORPORATION COMMISSION  
CONSERVATION DIVISION  
P. O. BOX 17027  
WICHITA, KANSAS 67217

FORM CP-4

WELL PLUGGING RECORD

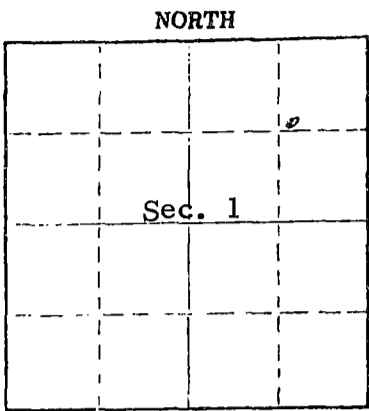

Locate well correctly on above Section Plat

Clark County, Sec. 1 Twp. 34S Rge. (E) 25(W)  
Location as "NE/CNW&SW" or footage from lines. 1250' FNL 1250' FEL  
Lease Owner Mesa Petroleum Co.  
Lease Name Klinger Well No. 1-1  
Office Address P.O. Box 2009 Amarillo, TX 79103  
Character of Well (completed as Oil, Gas or Dry Hole) Gas Well  
Date well completed 9/2/76 19\_\_  
Application for plugging filed December 16, 1977 19\_\_  
Application for plugging approved December 19, 1977 19\_\_  
Plugging commenced December 27 1977  
Plugging completed December 31 1977  
Reason for abandonment of well or producing formation depleted - dry

If a producing well is abandoned, date of last production November 19 77  
Was permission obtained from the Conservation Division or its agents before plugging was commenced? Yes

Name of Conservation Agent who supervised plugging of this well Clarence Thomas  
Producing formation Chester Depth to top 5698' Bottom 5853' Total Depth of Well 5853' Feet  
Show depth and thickness of all water, oil and gas formations.

OIL, GAS OR WATER RECORDS

CASING RECORD

FORMATION	CONTENT	FROM	TO	SIZE	PUT IN	PULLED OUT
				2 7/8"	5839'	1920.21'
				9 5/8"	1001'	None

RECEIVED  
STATE CORPORATION COMMISSION  
JAN 18 1978  
CONSERVATION DIVISION  
Wichita, Kansas

Describe in detail the manner in which the well was plugged, indicating where the mud fluid was placed and the method or methods used in introducing it into the hole. If cement or other plugs were used, state the character of same and depth placed, from \_\_\_\_\_ feet to \_\_\_\_\_ feet for each plug set.

12-27-77 Pumped 5 sks. cement and 2- 2 7/8" rubber plugs to 5400'.  
12-31-77 Pumped 60 sks. cement from 1051' to 951'. Capped surface with 20 sks. cement from 4' to 34'. Cut off surface pipe and welded on steel plate.

Name of Plugging Contractor Lillard & Wilson, Inc. Permit # 618  
Address P.O. Box 962 Woodward, OK 73801

STATE OF Texas COUNTY OF Potter ss.  
Mesa Petroleum Co. (employee or owner) or (owner or operator) of the above-described

well, being first duly sworn on oath, says: That I have knowledge of the facts, statements, and matters herein contained and the log of the above-described well as filed and that the same are true and correct. So help me God.

(Signature) George Ripon  
P. O. Box 2009, Amarillo, Tx., 79105  
(Address)

SUBSCRIBED AND SWORN TO before me this 16th day of January, 19 78

My commission expires 2/28/79  
Notary Public.

KSCC (2); xc 1/16/78 - Mesa Dvr. Office, L.C.,