


STATE OF KANSAS
STATE CORPORATION COMMISSION

Form CP-4

Give All Information Completely
Make Required Affidavit
Mail or Deliver Report to:
Conservation Division
State Corporation Commission
212 No. Market
Wichita, Kansas

WELL PLUGGING RECORD

Clark County, Sec. 9 Twp. 34 Rge. (E) 24 (W)
NE SW

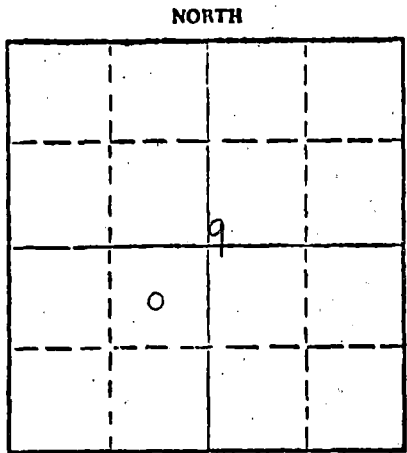

Locate well correctly on above Section Plat

Location as "NE/CNW/SW" or footage from lines
Lease Owner Inexco Oil Company
Lease Name Gardiner Well No. 2
Office Address 308 Lincoln Tower Building Denver, Colorado 80203
Character of Well (completed as Oil, Gas or Dry Hole) dry
Date well completed Aug. 18, 1973
Application for plugging filed 19
Application for plugging approved 19
Plugging commenced Aug. 18, 1973
Plugging completed Aug. 18, 1973
Reason for abandonment of well or producing formation _____

If a producing well is abandoned, date of last production 19
Was permission obtained from the Conservation Division or its agents before plugging was commenced? yes

Name of Conservation Agent who supervised plugging of this well _____
Producing formation _____ Depth to top _____ Bottom _____ Total Depth of Well 5850 Feet
Show depth and thickness of all water, oil and gas formations.

OIL, GAS OR WATER RECORDS

CASING RECORD

FORMATION	CONTENT	FROM	TO	SIZE	PUT IN	PULLED OUT
				13 3/8"	252'	

Describe in detail the manner in which the well was plugged, indicating where the mud fluid was placed and the method or methods used in introducing it into the hole. If cement or other plugs were used, state the character of same and depth placed, from _____ feet to _____ feet for each plug set.

- 35 sx. 800' - 700'
- 50 sx. 250' - 150'
- 15 sx. 45' - bottom of cellar

RECEIVED
STATE CORPORATION COMMISSION
AUG 30 1973
CONSERVATION DIVISION
Wichita, Kansas

(If additional description is necessary, use BACK of this sheet)
Name of Plugging Contractor Zenith Drilling Corporation, Inc.
Address Suite 600 - 200 W. Douglas Wichita, Kansas 67202

STATE OF Kansas, COUNTY OF Sedgwick, ss.
C. Robert Buford (employee of owner) or (~~owner or operator~~) of the above-described well, being first duly sworn on oath, says: That I have knowledge of the facts, statements, and matters herein contained and the log of the above-described well as filed and that the same are true and correct. So help me God.

(Signature) C. Robert Buford
Suite 600 - 200 W. Douglas Wichita, Kansas 67202
(Address)

SUBSCRIBED AND SWORN TO before me this 21st day of August, 1973

My commission expires August 15, 1975
Myron S. Murphy Notary Public.

WELL LOG

COMPANY Inexco Oil Company

SEC. 9-34-24W

FARM Gardiner

NO. 2

LOC. NE SW

TOTAL DEPTH 5850'

COUNTY Clark


COMM. 8-2-73

COMP. 8-18-73

CONTRACTOR Zenith Drilling Corporation, Inc.

CASING

13 3/8" @ 252' w/225 sx.

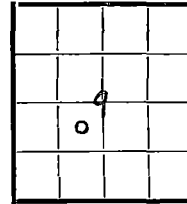

ELEVATION

PRODUCTION

FIGURES INDICATE BOTTOM OF FORMATIONS

- 220' Sand, Clay
- 1206' Red Bed
- 1580' Red Bed, Anhydrite
- 2345' Red Bed, Clay
- 4770' Lime, Shale
- 5850' Lime

RECEIVED
 STATE CORPORATION COMMISSION
 AUG 30 1973
 CONSERVATION DIVISION
 Wichita, Kansas

State of Kansas }
 County of Sedgwick } ss

I, C. Robert Buford, President of Zenith Drilling Corporation, Inc.
 upon oath state the above and foregoing is a true and correct copy of the log of the Gardiner #2 well.

C. Robert Buford

Subscribed and sworn to before me this 21 day of August, 1973.

My Commission Expires: Aug. 15, 1975

Myrna S. Murphy
 NOTARY PUBLIC