

STATE OF KANSAS
STATE CORPORATION COMMISSION

WELL PLUGGING RECORD

Give All Information Completely
Make Required Affidavit
Mail or Deliver Report to
Conservation Division
State Corporation Comm.
245 North Water
Wichita, KS 67202

Clark County. Sec. 8 Twp. 34S Rge. 24W E/W
Location as "NE/CNW $\frac{1}{4}$ SW $\frac{1}{4}$ " or footage from lines
SW NW


Lease Owner Harkin Oil & Gas Inc.
Lease Name Gardiner Thomas Well No. 1
Office Address Drawer 3057, Abilene, Texas 79604
Character of Well (Completed as Oil, Gas or Dry Hole) Dry

Date Well completed Oct. 17 1978
Application for plugging filed Oct. 16 1978
Application for plugging approved Oct. 16 1978
Plugging commenced Oct. 17 1978
Plugging completed Oct. 17 1978

Reason for abandonment of well or producing formation
Rig caved in - skid to new location
If a producing well is abandoned, date of last production 19

Was permission obtained from the Conservation Division or its agents before plugging was commenced? Yes

Name of Conservation Agent who supervised plugging of this well
Producing formation Depth to top Bottom Total Depth of Well
Show depth and thickness of all water, oil and gas formations.

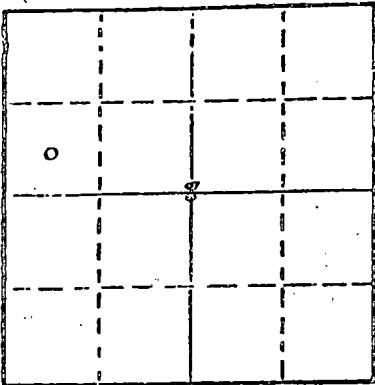

Locate well correctly on above Section Plot

OIL, GAS OR WATER RECORDS

CASING RECORD

FORMATION	CONTENT	FROM	TO	SIZE	PUT IN	PULLED OUT
		0	75	20	75	None

Describe in detail the manner in which the well was plugged, indicating where the mud fluid was placed and the method or methods used in introducing it into the hold. If cement or other plugs were used, state the character of same and depth placed, from feet to feet for each plug set.

Plugged:
35 sacks @ 500
35 sacks @ 70
20 of Conductor filled w/cement
5 sacks in mousehole; 5 sacks in rathole.

RECEIVED
STATE CORPORATION COMMISSION

JAN 29 1979

(If additional description is necessary, use BACK of this sheet)

Name of Plugging Contractor DaMac Drilling Inc. CONSERVATION DIVISION
Box 1164, Great Bend, Ks. 67530 Wichita, Kansas


STATE OF Kansas COUNTY OF Barton ss.
Martha J. McKown (employee of owner) or (owner or operator) of the above-described well, being first duly sworn on oath, says: That I have knowledge of the facts, statements, and matters herein contained and the log of the above-described well as filed and that the same are true and correct. So help me God.

(Signature) Martha J. McKown
Box 1164, Great Bend, Kansas 67530
(Address)

SUBSCRIBED AND SWORN TO before me this 23rd day of January, 1979

My commission expires 4-11-81

Lana L. Remmert
Notary Public.

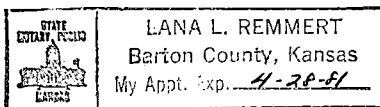

WELL LOG

COMPANY Harkin Oil & Gas Inc.

SEC. 8 T. 34S R. 24W

FARM Gardiner-Thomas Unit NO. 1

LOC. SW NW

TOTAL DEPTH 550

COUNTY Clark

COMM. 10-4-78 COMP. 10-17-78

CONTRACTOR DaMac Drilling Inc.

CASING Conductor Casing set @ 75'

ELEVATION

PRODUCTION

FIGURES INDICATE BOTTOM OF FORMATIONS

Surface Sand	0	550
--------------	---	-----

RECEIVED
STATE CORPORATION COMMISSION

JAN 29 1979

CONSERVATION DIVISION
Wichita, Kansas

State of Kansas }
 County of Barton } SS

I, Martha J. McKown of DaMac Drilling Inc.

upon oath state the above and foregoing is a true and correct copy of the log of the Gardiner-Thomas well.

Martha J. McKown

Subscribed and sworn to before me this 22nd day of January 19 79

My Commission Expires: 4-28-81

Lana L. Remmert

STATE NOTARY PUBLIC
 KANSAS
 LANA L. REMMERT
 Barton County, Kansas
 My Appt. Exp. 4-28-81

NOTARY PUBLIC