

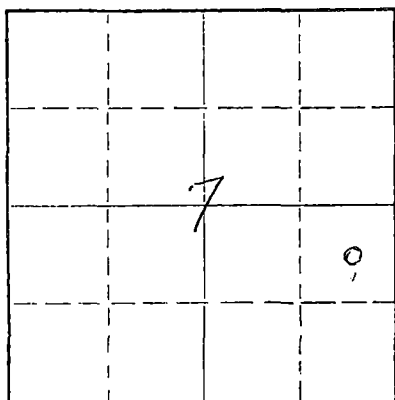
STATE OF KANSAS  
STATE CORPORATION COMMISSION

Form CP-4

Give All Information Completely  
Make Required Affidavit  
Mail or Deliver Report to:  
Conservation Division  
State Corporation Commission  
212 No. Market  
Wichita, Kansas 67202

## WELL PLUGGING RECORD

NORTH

Locate well correctly on above  
Section Plat

Meade County, Sec. 7 Twp. 34 Rge. 29W (E) (W)

Location as "NE/CNW%SW%" or footage from lines NE SE

Lease Owner Nabob Production Co.

Lease Name H. G. Adams Well No. 1

Office Address P.O. Box 448 Amarillo, Texas 79105

Character of Well (completed as Oil, Gas or Dry Hole)

Date well completed 19

Application for plugging filed 19

Application for plugging approved 19

Plugging commenced 3/16 1971

Plugging completed 3/20 1971

Reason for abandonment of well or producing formation

If a producing well is abandoned, date of last production 19

Was permission obtained from the Conservation Division or its agents before plugging was commenced? yes

Name of Conservation Agent who supervised plugging of this well E. Eves

Producing formation None Depth to top Bottom Total Depth of Well 6475 Feet

Show depth and thickness of all water, oil and gas formations.

## OIL, GAS OR WATER RECORDS

## CASING RECORD

FORMATION	CONTENT	FROM	TO	SIZE	PUT IN	PULLED OUT
Water Sand		150	410	8 5/8	1516'	None
No Oil & Gas						

Describe in detail the manner in which the well was plugged, indicating where the mud fluid was placed and the method or methods used in introducing it into the hole. If cement or other plugs were used, state the character of same and depth placed, from feet to feet for each plug set.

Mix and pump 20 sks. cement and 1sk. hulls to plug perfs.

Stop plug at 5,500'.

Pump 35 Sks. Cement at 900' to 800'.

Put 15 sks. cement at 45' to 0'.

RECEIVED  
STATE CORPORATION COMMISSION  
MAY 3 1971  
CONSERVATION DIVISION  
Wichita, Kansas

(If additional description is necessary, use BACK of this sheet)

Name of Plugging Contractor Sargents Casing Pulling Service

Address Box 506, Liberal, Kansas 67901

STATE OF TEXAS, COUNTY OF POTTER, ss.

Nabob Production Company

(Employee of Owner) or (owner or operator) of the above-described

well, being first duly sworn on oath, says: That I have knowledge of the facts, statements, and matters herein contained and the log of the above-described well as filed and that the same are true and correct. So help me God.

(Signature) W. B. B. B.

P.O. Box 448 Amarillo, Texas 79105

(Address)

SUBSCRIBED AND SWORN TO before me this 29th day of April, 1971

My commission expires June 1, 1971

Notary Public.

## NABOB PRODUCTION COMPANY

H.G. Adams  
Meade County Kansas

Spudded 7/17/70  
Completed 8/2/70

0- 150	Surface
150- 410	Water Sand
410-1,488	Red bed & Shale
1,488-1,804	Anhy. & Shale
1,804-2,315	Shale & Lime
2,315-2,438	Shale, Anhy., Lime
2,438-2,610	Anhy., Lime
2,610-4,039	Lime & Shale
4,039-4,386	Shale
4,386-6,475 T.D.	Lime & Shale

RECEIVED  
STATE CORPORATION COMMISSION  
MAY 3 1971  
CONSERVATION DIVISION  
Wichita, Kansas