


STATE OF KANSAS  
STATE CORPORATION COMMISSION

Form CP-4

Give All Information Completely  
Make Required Affidavit  
Mail or Deliver Report to:  
Conservation Division  
State Corporation Commission  
212 No. Market  
Wichita, Kansas 67202

WELL PLUGGING RECORD

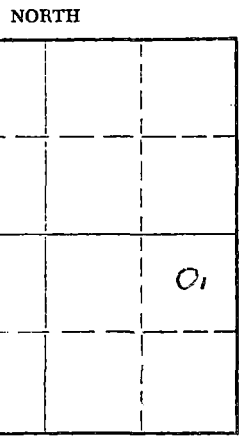

Locate well correctly on above  
Section Plat

Meade County. Sec. 7 Twp. 34 S Rge. 29W (E) (W)  
Location as "NE/CNWxSWx" or footage from lines 1,980' FSL & 660' FEL  
Lease Owner Nabob Production Company  
Lease Name H. G. Adams Well No. 1  
Office Address P. O. Box 448 Amarillo, Texas 79105  
Character of Well (completed as Oil, Gas or Dry Hole) Dry Hole  
Date well completed 8/2 19 70  
Application for plugging filed 8/18 19 70  
Application for plugging approved (by telephone) 8/2 19 70  
Plugging commenced 8/2 19 70  
Plugging completed 8/2 19 70  
Reason for abandonment of well or producing formation Dry Hole

If a producing well is abandoned, date of last production 19  
Was permission obtained from the Conservation Division or its agents before plugging was commenced? Yes

Name of Conservation Agent who supervised plugging of this well Eddie Eves  
Producing formation None Depth to top Bottom Total Depth of Well 6,475 Feet  
Show depth and thickness of all water, oil and gas formations.

OIL, GAS OR WATER RECORDS

CASING RECORD

FORMATION	CONTENT	FROM	TO	SIZE	PUT IN	PULLED OUT
Water Sand	Water	150	410	8 5/8	1,516'	None
No Oil or Gas Found						

Describe in detail the manner in which the well was plugged, indicating where the mud fluid was placed and the method or methods used in introducing it into the hole. If cement or other plugs were used, state the character of same and depth placed, from feet to feet for each plug set.

Mix & Spot 35 sks. cement plug from 1,100' to 1,000'  
Mix & Spot 15 sks. cement plug from 45' to Surface

RECEIVED  
STATE CORPORATION COMMISSION  
AUG 21 1970  
CONSERVATION DIVISION  
Wichita, Kansas

(If additional description is necessary, use BACK of this sheet)  
Name of Plugging Contractor Drilling Contractor using Haliburton to pump in cement.  
Address

STATE OF Texas, COUNTY OF Potter, ss.

(employee of owner) or (owner or operator) of the above-described well, being first duly sworn on oath, says: That I have knowledge of the facts, statements, and matters herein contained and the log of the above-described well as filed and that the same are true and correct. So help me God.

(Signature) W.B. Rich  
Box 448 Amarillo, Texas  
(Address)

SUBSCRIBED AND SWORN TO before me this 18th day of August, 19 70

My commission expires June 1, 1971  
Notary Public.

15-119-20055-0000

NABOB PRODUCTION COMPANY

H.G. Adams #1

Meade County Kansas

SEC. 7, T 34 S R 29 W

Spudded 7/17/70

Completed 8/2/70

0-	150	Surface
150-	410	Water Sand
410-	1,488	Red bed & Shale
1,488-	1,804	Anhy. & Shale
1,804-	2,315	Shale & Lime
2,315-	2,438	Shale, Anhy., Lime
2,438-	2,610	Anhy., Lime
2,610-	4,039	Lime & Shale
4,039-	4,386	Shale
4,386-	6,475	T.D. Lime & Shale

RECEIVED  
STATE CORPORATION COMMISSION  
AUG 21 1970  
CONSERVATION DIVISION  
Wichita, Kansas