

KCC


15-119-10317-0000

STATE OF KANSAS
STATE CORPORATION COMMISSION

Give All Information Completely
Make Required Affidavit
Mail or Deliver Report to:
Conservation Division
State Corporation Commission
800 Bitting Building
Wichita, Kansas

WELL PLUGGING RECORD

NORTH

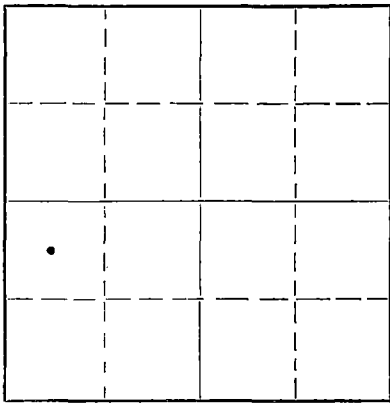

Locate well correctly on above
Section Plat

Meade County, Sec. 7 Twp. 34 Rge. (E) 29 (W)

Location as "NE/CNW/SW" or footage from lines C - NW - SW

Lease Owner White Eagle Oil Company

Lease Name Adams A Well No. 3

Office Address 1st Natl. Bank Bldg., Tulsa 3, Oklahoma

Character of Well (completed as Oil, Gas or Dry Hole) Dry hole

Date well completed 6-11-52 19

Application for plugging filed 6-12-52 19

Application for plugging approved 6-13-52 19

Plugging commenced 6-12-52 19

Plugging completed 7-18-52 19

Reason for abandonment of well or producing formation Dry hole

If a producing well is abandoned, date of last production 19

Was permission obtained from the Conservation Division or its agents before plugging was commenced? Yes

Name of Conservation Agent who supervised plugging of this well M. A. Rives

Producing formation Depth to top Bottom Total Depth of Well 5958 Feet

Show depth and thickness of all water, oil and gas formations.

OIL, GAS OR WATER RECORDS

CASING RECORD

FORMATION	CONTENT	FROM	TO	SIZE	PUT IN	PULLED OUT
Lansing - Kansas	Dry	4635	1985	13-3/8"	612'	None
Marmaton	"	5290		9-5/8"	2760'	1901'
Morrow	"	5852	3202			

Describe in detail the manner in which the well was plugged, indicating where the mud fluid was placed and the method or methods used in introducing it into the hole. If cement or other plugs were used, state the character of same and depth placed, from feet to feet for each plug set.

Hole filled with heavy drilling mud.

25 sack cement plug placed 2083' to 2145'.

Pipe shot off at 1887' and pulled.

25 sacks cement placed at 590' cementing off bottom of surface casing.

~~XXXXXXXXXXXXXXXXXXXX~~

After this 25 sacks of cement was placed at 590' the balance of the surface casing (13-3/8") was left, cap not being placed at the surface, as the land owner wishes to use this for a water well.

(If additional description is necessary, use BACK of this sheet)

Name of Plugging Contractor
Address

STATE OF Oklahoma, COUNTY OF Tulsa, ss.

Harry Saye (employee of owner) or (owner or operator) of the above-described

well, being first duly sworn on oath, says: That I have knowledge of the facts, statements, and matters herein contained and the log of the above-described well as filed and that the same are true and correct. So help me God.

(Signature) Harry Saye

1st Natl. Bank Bldg., Tulsa 3, Oklahoma (Address)

SUBSCRIBED AND SWORN TO before me this 30th day of July 19 52

My commission expires 8-29-55

Notary Public.

24-2675-S 2-52-20M

PLUGGING
SEC 7 T 34 R 29
PAGE 23 LINE 6


RECEIVED
STATE CORPORATION COMMISSION
AUG - 2 1952
CONSERVATION DIVISION

WHITE EAGLE OIL COMPANY

640 Acres

N T. 34S

WELL RECORD

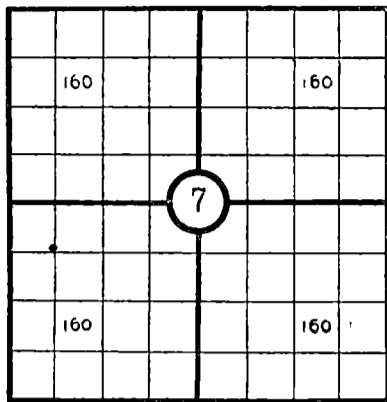

Locate well correctly

R. 29W

STATE Kansas

COUNTY Meade, SEC. 7, TWP. 34S, RGE. 29W

COMPANY OPERATING White Eagle Oil Company

OFFICE ADDRESS 1st Natl. Bank Bldg., Tulsa 3, Oklahoma

FARM NAME Adams A WELL NO. 3

DRILLING STARTED 5-10-52, DRILLING FINISHED 6-11-52

DATE OF FIRST PRODUCTION _____ COMPLETED _____

WELL LOCATED C $\frac{1}{4}$ NW $\frac{1}{4}$ SW $\frac{1}{4}$ 1980 ft. North of South

Line and 660 ft. East of West Line of Quarter Section

Elevation (Relative to sea level) DERRICK FLOOR 2647 ft. GROUND 2638 ft.

CHARACTER OF WELL (Oil, gas or dryhole) Dry hole

OIL OR GAS SANDS OR ZONES

Name	From	To	Name	From	To
1 <u>Lansing - Kansas City</u>	<u>4635</u>	<u>1985</u>	<u>4</u>		
2 <u>Marmaton</u>	<u>5290</u>		<u>5</u>		
3 <u>Morrow</u>	<u>5852</u>	<u>3202</u>	<u>6</u>		

Perforating Record If Any

Shot Record

Formation	From	To	No. of Holes	Formation	From	To	Size of Shot

CASING RECORD

Amount Set						Amount Pulled			Packer Record		
Size	Wt.	Thds.	Make	Ft.	In.	Ft.	In.	Size	Length	Depth Set	Make
<u>13-3/8</u>	<u>48#</u>	<u>8</u>	<u>H-40</u>	<u>612</u>		<u>none</u>					
<u>9-5/8</u>	<u>40#</u>	<u>8</u>	<u>J-55</u>	<u>2760</u>		<u>1901</u>		<u>9-5/8"</u>			

Liner Record: Amount _____ Kind _____ Top _____ Bottom _____

Size	CEMENTING					Method of Cementing	MUDDING		
	Amount Set		Sacks Cement	Chemical			Amount	Mudding Method	Results (See Note)
	Ft.	In.		Gal.	Make				
<u>13-3/8</u>	<u>612</u>		<u>500</u>			<u>Halliburton</u>			
<u>9-5/8</u>	<u>2760</u>		<u>500</u>						

Note: What method was used to protect sands if outer strings were pulled?
Spotted 25 sacks cement at 2083 to 2145 25 sacks spotted at 590'

NOTE: Were bottom hole plugs used? _____ If so, state kind, depth set and results obtained _____

TOOLS USED

Rotary tools were used from 0 feet to 5958 feet, and from _____ feet to _____ feet
 Cable tools were used from _____ feet to _____ feet, and from _____ feet to _____ feet
 Type Rig _____

INITIAL PRODUCTION TEST

Describe initial test: whether by flow through tubing or casing or by pumping Dry hole

Amount of Oil Production _____ bbls. Size of choke, if any _____ Length of test _____ Water Production _____ bbls.

Gravity of oil _____ Type of Pump if pump is used, describe _____

Open Flow _____ M.C.F. Length of test _____ Water Production _____ bbls.

Deliverability _____

RECEIVED
STATE CORPORATION COMMISSION

PLUGGING
AUG 11 1952

FILE NO. 739 270
BOOK PAGE 23 LINE 6

OPERATION DIVISION

Adams "A" Well No. 3
NW SW Section 7-34S-29W
Meade County, Kansas
White Eagle Oil Co.

Commenced: May 10, 1952
Completed: June 11, 1952

CASING RECORD:

Set 13 3/8" Casing @ 612' with 500 Sacks
Set 9 5/8" Casing @ 2760 with 500 Sacks

Red Bed	0	280
Sand & Shale	280	589
Shale & Red Bed	589	932
Shale & Sand	932	1118
Shale & Shells	1118	1298
Shale & Lime	1298	1447
Shale & Salt	1447	1637
Shale & Shells	1637	1650
Shale & Lime	1650	2125
Shale, Lime, Anhydrite	2125	2200
Lime	2200	2347
Shale & Lime	2347	2390
Shale, Lime, Anhydrite	2390	2455
Lime	2455	3862
Shale & Lime	3862	4162
Shale	4162	4262
Shale & Lime	4262	4652
Lime	4652	4771
Lime & Shale	4771	4799
Lime	4799	4881
Lime, Shale	4881	4993
Lime	4993	5068
Lime, Shale	5068	5108
Lime	5108	5584
Lime, Shale	5584	5718
Shale	5718	5776
Shale, Lime	5776	5958
TOTAL DEPTH		5958

STATE OF OKLAHOMA)ss
COUNTY OF TULSA)

I hereby affirm that the above and foregoing is a true and correct copy of the log of the Adams "A" No. 3 Well, located in the Northwest of the Southwest Section 7, Township 34 South, Range 29 West, Meade County, Kansas.

HELMERICH & PAYNE, INC.

By [Signature]
Vice-President

Subscribed and sworn to before me, a Notary Public, this 25th day of June, 1952.

[Signature]
Notary Public

My Commission expires March 13, 1954.

RECORDED
INDEXED
CORPORATION
AND
CONSERVATION