

STATE OF KANSAS
STATE CORPORATION COMMISSION

WELL PLUGGING RECORD

Give All Information Completely
Make Required Affidavit
Mail or Deliver Report to:
Conservation Division
State Corporation Commission
800 Bitting Building
Wichita, Kansas

Meade County, Sec. 7 Twp. 34 Rge. 29 (A) (W)

Location as "NE/CNW $\frac{1}{4}$ SW $\frac{1}{4}$ " or footage from lines Gen NE NW

Lease Owner J.M. Huber Corp.

Lease Name Adams-Bronwell Well No. 1

Office Address Box 978 Liberal, Kans.

Character of Well (completed as Oil, Gas or Dry Hole) Dry Hole

Date well completed 9-18-53 19

Application for plugging filed 9-22-53 19

Application for plugging approved 9-18-53 19


Plugging commenced 9-18-53 19

Plugging completed 9-18-53 19

Reason for abandonment of well or producing formation Dry Hole

If a producing well is abandoned, date of last production 19

Was permission obtained from the Conservation Division or its agents before plugging was commenced? yes

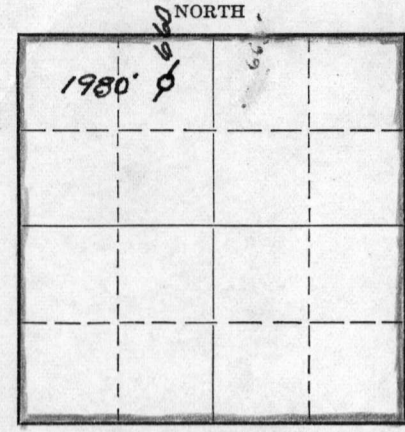

Locate well correctly on above Section Plat

Name of Conservation Agent who supervised plugging of this well C.D. Stough

Producing formation Depth to top Bottom Total Depth of Well 6100 Feet

Show depth and thickness of all water, oil and gas formations.

OIL, GAS OR WATER RECORDS

CASING RECORD

Formation	Content	From	To	Size	Put In	Pulled Out
				13 3/8	625'	none
				9 5/8	2500'	

Describe in detail the manner in which the well was plugged, indicating where the mud fluid was placed and the method or methods used in introducing it into the hole. If cement or other plugs were used, state the character of same and depth placed, from feet to feet for each plug set.

Filled hole with mud from 6100' to 400'. Set cementing plug, 1 sack of hulls, 25 sacks cement at 400'. Filled hole with mud, to 35'. Set cementing plug and 1 sack of hulls at 35'. Filled to surface with 14 sacks cement.

RECEIVED
STATE CORPORATION COMMISSION
SEP 26 1953
CONSERVATION DIVISION
Wichita, Kansas

(If additional description is necessary, use BACK of this sheet)
Name of Plugging Contractor J.M. Huber Corp.
Address Box 978 Liberal, Kansas

STATE OF Kansas COUNTY OF Seward, ss.
R.E. McDaniel (employee of owner) or (owner or operator) of the above-described well,

being first duly sworn on oath, says: That I have knowledge of the facts, statements, and matters herein contained and the log of the above-described well as filed and that the same are true and correct. So help me God.

(Signature) RE McDaniel

Box 978, Liberal, Kansas (Address)

SUBSCRIBED AND SWORN to before me this 24 day of Sept, 1953

My commission expires July 27, 1957 Notary Public.

WELL LOG

Well name: J.M. Huber #1 Adams-Bromwell
 Location: Cen. NE NW Sec 7 Twp 34S Rge 29W
 Meade Co., Kansas
 Commenced: 8-21-53
 Completed: 9-18-53
 Test Data: Dry hole
 Total Depth: 6100'

<u>FORMATION</u>	<u>DEPTH</u>
Surface sand & shells	0-580'
Red bed and shale	580-1638'
Shale and shells	1638-1935'
Lime and shale	1935-2502'
Lime	2502-3790'
Lime and shale	3790-3995'
Shale	3995-4380'
Lime and shale	4380-4700'
Lime	4700-5571'
Lime and shale	5571-5820'
Lime	5820-6100'

STATE OF KANSAS, COUNTY OF SEWARD, SS

I, R.E. McDaniel of the J.M. Huber Corp., being first duly sworn on oath, state: That I have knowledge of the facts, statements and matters herein contained and that the same are true and correct.

R E McDaniel

Subscribed and sworn to before me this 22 day of Sept 1953

J. R. Ryler
Notary Public

My Commission Expires:

July 27, 1957

PLUGGING
 FILE SEC 7 T 34 R 29W
 BOOK PAGE 131 LINE 1

RECEIVED
 STATE CORPORATION COMMISSION
 SEP 26 1953
 CONSERVATION DIVISION
 Wichita, Kansas