


STATE OF KANSAS  
STATE CORPORATION COMMISSION

Form CP-4

Give All Information Completely  
Make Required Affidavit  
Mail or Deliver Report to:  
Conservation Division  
State Corporation Commission  
P. O. Box 17027  
Wichita, Kansas 67217  
NORTH

WELL PLUGGING RECORD

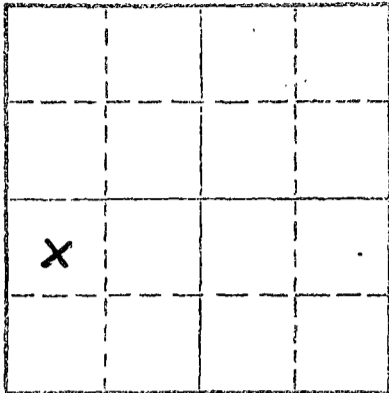

Locate well correctly on above  
Section Plat

Seward County, Sec. 12 Twp. 34S. Rge. 31 (E) W (W)  
Location as "NE/CNW/SE/SW" or footage from lines C NW/4 SW/4

Lease Owner THE WIL-MC OIL CORP.

Lease Name HILBIG Well No. 1

Office Address 607 Fidelity Union Life Bldg., Dallas, Texas

Character of Well (completed as Oil, Gas or Dry Hole) Dry Hole

Date well completed 19

Application for plugging filed 5/23/74 19

Application for plugging approved verbally prior to plugging 19

Plugging commenced 5/8/74 19

Plugging completed 5/8/74 19

Reason for abandonment of well or producing formation Dry Hole

If a producing well is abandoned, date of last production 19

Was permission obtained from the Conservation Division or its agents before plugging was commenced? yes

Name of Conservation Agent who supervised plugging of this well

Producing formation Depth to top Bottom Total Depth of Well 6120 Feet

Show depth and thickness of all water, oil and gas formations.

OIL, GAS OR WATER RECORDS

CASING RECORD

FORMATION	CONTENT	FROM	TO	SIZE	PUT IN	PULLED OUT
				16	65'	None
				8-5/8	1508'	None

Describe in detail the manner in which the well was plugged, indicating where the mud fluid was placed and the method or methods used in introducing it into the hole. If cement or other plugs were used, state the character of same and depth placed, from feet to feet for each plug set.

35 sx. Plug @ 1000'

15 sx. Plug @ 45'

5 sx. in rathole and

5 sx. in mousehole

RECEIVED  
STATE CORPORATION COMMISSION

MAY 28 1974

CONSERVATION DIVISION  
Wichita, Kansas

Name of Plugging Contractor Stickle Drilling Company  
Address Wichita, Kansas

STATE OF Texas, COUNTY OF Dallas  
Derrel C. Melton, Agent

(employee of owner) or (owner or operator) of the above-described well, being first duly sworn on oath, says: That I have knowledge of the facts, statements, and matters herein contained and the log of the above-described well as filed and that the same are true and correct. So help me God.

(Signature) Derrel Melton  
607 Fidelity Union Life Bldg.  
Dallas, Texas 75201  
(Address)

SUBSCRIBED AND SWORN TO before me this 23rd day of May 1974

My commission expires 6/1/75  
Linda Ludea  
Notary Public