


STATE OF KANSAS
STATE CORPORATION COMMISSION

WELL PLUGGING RECORD

Give All Information Completely
Make Required Affidavit
Mail or Deliver Report to
Conservation Division
State Corporation Comm.
245 North Water
Wichita, KS 67202

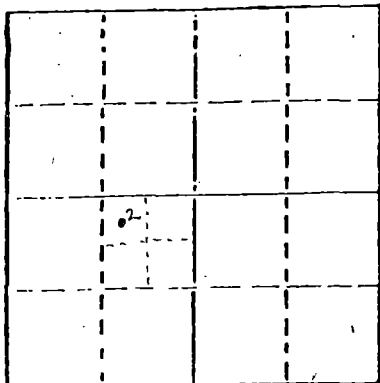

Locate well correctly on above
Section Plot

CHAUTAUQUA County, Sec. 8 Twp. 34S Rge. 10 E
Location as "NE/CNW $\frac{1}{4}$ SW $\frac{1}{4}$ " or footage from lines NW NE SW
330' FNL & 990' FEL SW $\frac{1}{4}$

Lease Owner WELLS-BATTELSTEIN OIL & GAS, INC.
Lease Name BARNETT Well No. 2
Office Address 17 S. ASHBY, CHANUTE, KANSAS 66720
Character of Well (Completed as Oil, Gas or Dry Hole)
DRY HOLE

Date Well completed 6-17 1982
Application for plugging filed 6-17 1982
Application for plugging approved 6-17 1982
Plugging commenced 6-17 1982
Plugging completed 6-17 1982
Reason for abandonment of well or producing formation
WAYSIDE

If a producing well is abandoned, date of last production
19

Was permission obtained from the Conservation Division or
its agents before plugging was commenced? YES

Name of Conservation Agent who supervised plugging of this well LEON WINTERS
Producing formation WAYSIDE Depth to top Bottom Total Depth of Well 1550
Show depth and thickness of all water, oil and gas formations.

OIL, GAS OR WATER RECORDS

CASING RECORD

FORMATION	CONTENT	FROM	TO	SIZE	PUT IN	PULLED OUT

Describe in detail the manner in which the well was plugged, indicating where the mud fl
was placed and the method or methods used in introducing it into the hold. If cement or othe
plugs were used, state the character of same and depth placed from feet to
feet for each plug set.

170 sacks @ 510' to surface

STATE RECEIVED
AUG 26 1982
CONSERVATION DIVISION
Wichita, Kansas


(If additional description is necessary, use BACK of this sheet)

Name of Plugging Contractor CHANUTE WELL SERVICING

STATE OF KANSAS COUNTY OF NEOSHO, ss.
CARL LARCOM (ACTING AGENT) (employee of owner) or (owner or operator
of the above-described well, being first duly sworn on oath, says: That I have knowledge of
the facts, statements, and matters herein contained and the log of the above-described well
as filed and that the same are true and correct. So help me God.

(Signature) *Carl Larcom*
CARL LARCOM (ACTING AGENT)
17 So. Ashby, P.O. Box 762, Chanute, Ks.
(Address) 66720

SUBSCRIBED AND SWORN TO before me this 20th day of August, 1982

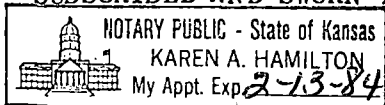

Karen A. Hamilton
Notary Public.
KAREN HAMILTON

My commission expires _____

FILL IN WELL LOG AS REQUIRED:

Show all important zones of porosity and contents thereof; cased intervals, and all drill-stem tests, including depth interval tested, cushion used, time tool open, flowing and shut-in pressures, and recoveries.

SHOW GEOLOGICAL MARKERS, LOGS RUN, OR OTHER DESCRIPTIVE INFORMATION.

FORMATION DESCRIPTION, CONTENTS, ETC.	TOP	BOTTOM	NAME	DEPTH
soil	0	3		
clay	3	10		
shale	10	19		
hard sand	19	24		
shale	24	28		
sand	28	31		
shale	31	46		
hard lime	46	89		
lime	89	95		
sand	95	103		
shale	103	139		
lime	139	145		
shale	145	241		
lime	241	243		
shale	243	256		
lime	256	258		
shale	258	302		
lime	302	316		
sandy lime	316	341		
shale	341	355		
red band	355	381		
lime	381	385		
shale	385	497		
sand	497	528		
shale	528	659		
lime	659	677		
shale	677	760		
sand	760	767		
sand & shale	767	817		
lime	817	818		
sandy shale	818	963		
lime	963	977		
shale	977	1019		
lime	1019	1024		
sandy shale	1024	1034		
lime	1034	1035		

STATE CORPORATION COMMISSION
 RECEIVED
 AUG 26 1982
 CONSERVATION DIVISION
 Wichita, Kansas

sand & shale	1035	1180		
sand & shale	1180	1242		
sand	1242	1281		
lime	1281	1286		
sandy shale	1286	1351		
lime	1351	1365		
sand & shale	1365	1420		
gray shale	1420	1509		
lenapah lime	1509	1520		
core #1	1520	1541		
sandy shale	1541	1550*T.D.	WAYSIDE	