


Give All Information Completely
Make Required Affidavit
Mail or Deliver Report to:
Conservation Division
State Corporation Commission
211 No. Broadway
Wichita, Kansas

WELL PLUGGING RECORD

NORTH

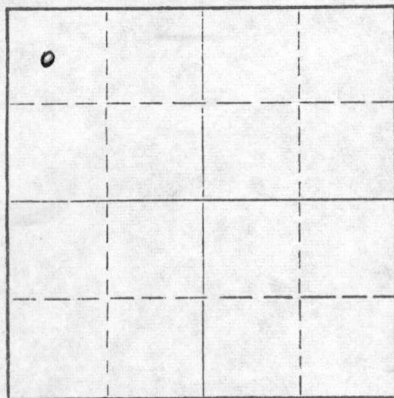

Locate well correctly on above
Section Plat

Harper County. Sec. 12 Twp. 34S Rge. 6 W (W)

Location as "NE/CNW/SW" or footage from lines C NW NW

Lease Owner V. W. McKnab

Lease Name H. D. Welch Well No. 1

Office Address 114 W. 11th, Winfield, Kansas

Character of Well (completed as Oil, Gas or Dry Hole) oil

Date well completed _____ 19 _____

Application for plugging filed 11-12 19 62

Application for plugging approved 11-13 19 62

Plugging commenced 11-16 19 62

Plugging completed 11-17 19 62

Reason for abandonment of well or producing formation low production

If a producing well is abandoned, date of last production _____ 19 _____

Was permission obtained from the Conservation Division or its agents before plugging was commenced? yes

Name of Conservation Agent who supervised plugging of this well Herman E. Justus

Producing formation _____ Depth to top _____ Bottom _____ Total Depth of Well 3822 Feet

Show depth and thickness of all water, oil and gas formations.

OIL, GAS OR WATER RECORDS

CASING RECORD

FORMATION	CONTENT	FROM	TO	SIZE	PUT IN	PULLED OUT
				8 5/8	300	circulated
				4 1/2	3821	3509.78

Describe in detail the manner in which the well was plugged, indicating where the mud fluid was placed and the method or methods used in introducing it into the hole. If cement or other plugs were used, state the character of same and depth placed, from _____ feet to _____ feet for each plug set.

Filled from 3822 to 3780 with sand, dumped 3 sacks cement.

Set 10 foot rock bridge at 200 fee, dumped 20 sacks cement.

Mud hole to 40 feet, set 10 foot rock bridge, dumped 10 sacks cement.

RECEIVED
STATE CORPORATION COMMISSION
NOV 26 1962
CONSERVATION DIVISION
Wichita, Kansas

(If additional description is necessary, use BACK of this sheet)
Name of Plugging Contractor Kent Well Servicing Co., Inc.
Address Box 470, El Dorado, Kansas

STATE OF Kansas, COUNTY OF Butler, ss.

_____, (employee of owner) or (owner or operator) of the above-described well, being first duly sworn on oath, says: That I have knowledge of the facts, statements, and matters herein contained and the log of the above-described well as filed and that the same are true and correct. So help me God.

(Signature) Mary Payne

(Address)

SUBSCRIBED AND SWORN TO before me this 24th day of November, 19 62

Ethelene E. Phillips

Notary Public.

My commission expires June 18, 1963

