


Give All Information Completely
Make Required Affidavit
Mail or Deliver Report to:
Conservation Division
State Corporation Commission
212 No. Market
Wichita, Kansas

WELL PLUGGING RECORD

Harper County. Sec. 12 Twp. 34 Rge. 6 (E) (W)
Location as "NE/CNW&SW" or footage from lines. C NE NW
Lease Owner J. A. Allison
Lease Name Mattingly Well No. 1
Office Address Box 1277, El Dorado, Kansas 1415 Wichita Plaza
Character of Well (completed as Oil, Gas or Dry Hole) D & A
Date well completed 4/2 1967
Application for plugging filed 4/2 1967
Application for plugging approved 4/2 1967
Plugging commenced 4/2 1967
Plugging completed 4/2 1967
Reason for abandonment of well or producing formation dry hole

NORTH

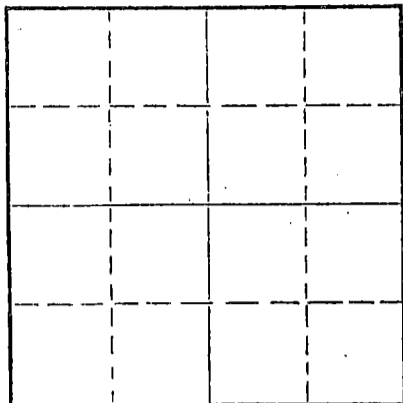

Locate well correctly on above
Section Plat

If a producing well is abandoned, date of last production none 19
Was permission obtained from the Conservation Division or its agents before plugging was commenced?

Name of Conservation Agent who supervised plugging of this well Archie Elving, Pratt, Kansas
Producing formation none Depth to top Bottom Total Depth of Well 3800 Feet
Show depth and thickness of all water, oil and gas formations.

OIL, GAS OR WATER RECORDS

CASING RECORD

FORMATION	CONTENT	FROM	TO	SIZE	PUT IN	PULLED OUT
Surface hole	water	surface	248'	8 5/8"		left in
(see attached log)						

Describe in detail the manner in which the well was plugged, indicating where the mud fluid was placed and the method or methods used in introducing it into the hole. If cement or other plugs were used, state the character of same and depth placed, from feet to feet for each plug set.

Filled hole with heavy drilling mud to 225', set plug, put in 1/2 sack hulls, 20 sacks cement. Filled hole with drilling mud to 30', set plug, put in 1/2 sack hulls and 8 sacks cement.

RECEIVED
STATE CORPORATION COMMISSION

APR 10 1967

CONSERVATION DIVISION
Wichita, Kansas

(If additional description is necessary, use BACK of this sheet)

Name of Plugging Contractor Donelson Drilling Company
Address 619 First National Bank Building, Wichita, Kansas

STATE OF KANSAS, COUNTY OF SEDGWICK, ss.
James L. Donelson (employer or operator) of the above-described well, being first duly sworn on oath, says: That I have knowledge of the facts, statements, and matters herein contained and the log of the above-described well as filed and that the same are true and correct. So help me God.

(Signature) James L. Donelson
619 First National Bank Building
(Address)

SUBSCRIBED AND SWORN to before me this 7th day of April, 1967

My commission expires April 16, 1969

Carolyn L. Scott
Notary Public.

MATTINGLY # 1

J. A. Allison

Total depth: 3800'

Elevation: 1224 KB 1219 GL

Contractor: Donelson Drilling Co.

Location: C NE NW

Commenced: 3/27/67

Section: 12-34-6W

Completed: 4/2/67

Harper County, Kansas

Initial Prod: D & A

Casing Record: 8 5/8" O.D. set @ 248' w/175 sks.

Formation

Depth

Surface hole

248'

Shale

925'

Shale & Lime

1500'

Lime & Shale

1730'

Shale & Lime

2360'

Lime & Shale

3767'

Lime (Brn. Lime)

3800' RBD

RECEIVED
STATE CORPORATION COMMISSION
APR 10 1967
CONSERVATION DIVISION
Wichita, Kansas

I hereby certify the foregoing statements are true and correct to the best of my knowledge and belief.

DONELSON DRILLING COMPANY

By James L. Donelson
James L. Donelson

STATE OF KANSAS)
) SS
COUNTY OF SEDGWICK)

Subscribed and sworn to before me, a Notary Public in and for said county and state, this 7 th day of April, 1967.

Caroline J. Scott
Notary Public

My Commission Expires: April 16, 1969