


Give All Information Completely  
Make Required Affidavit  
Mail or Deliver Report to:  
Conservation Division  
State Corporation Commission  
P. O. Box 17027  
Wichita, Kansas 67217  
NORTH

WELL PLUGGING RECORD

Harper County. Sec. 2 Twp. 34S Rge. (E) 8 (W)  
Location as "NE/CNWxSWx" or footage from lines C NW/4  
Lease Owner Petroleum Reserve Corporation  
Lease Name WHARTON Well No. 1  
Office Address 225 Cravens Building, Oklahoma City, Oklahoma 73102  
Character of Well (completed as Oil, Gas or Dry Hole) Dry Hole  
Date well completed May 7 19 73  
Application for plugging filed August 14 19 73  
Application for plugging approved August 16 19 73  
Plugging commenced August 21 19 73  
Plugging completed August 24 19 73  
Reason for abandonment of well or producing formation Non-commercial

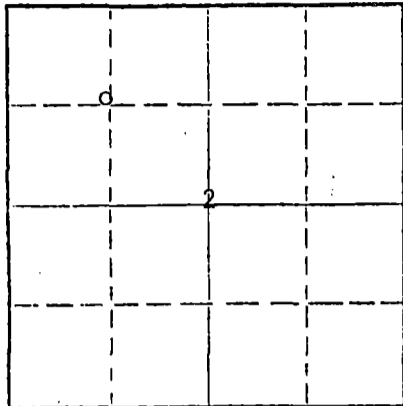

Locate well correctly on above Section Plat

If a producing well is abandoned, date of last production 19  
Was permission obtained from the Conservation Division or its agents before plugging was commenced? Yes

Name of Conservation Agent who supervised plugging of this well G. Russell Biberstein  
Producing formation None Depth to top Bottom Total Depth of Well 4703 Feet  
Show depth and thickness of all water, oil and gas formations.

OIL, GAS OR WATER RECORDS

CASING RECORD

FORMATION	CONTENT	FROM	TO	SIZE	PUT IN	PULLED OUT
Mississippian	Oil, gas & Water	4656	4692	8-5/8"	318'	None
				4-1/2"	4702'	3700'

Describe in detail the manner in which the well was plugged, indicating where the mud fluid was placed and the method or methods used in introducing it into the hole. If cement or other plugs were used, state the character of same and depth placed, from feet to feet for each plug set.

Halliburton pumped 50 sack plug common cement down tubing. Top of bottom plug at 4620'.  
Top plug from surface to 300' (4 yards Ready Mix)

RECEIVED  
STATE CORPORATION COMMISSION  
AUG 28 1973  
CONSERVATION DIVISION  
Wichita, Kansas

(If additional description is necessary, use BACK of this sheet)  
Name of Plugging Contractor Clyde A. Reeves & Son, Inc.  
Address 3251 S. E. 29th, Oklahoma City, Oklahoma

STATE OF OKLAHOMA, COUNTY OF OKLAHOMA, ss.  
John C. Roberts (employee of owner) or (owner or operator) of the above-described well, being first duly sworn on oath, says: That I have knowledge of the facts, statements, and matters herein contained and the log of the above-described well as filed and that the same are true and correct. So help me God.

(Signature) John C. Roberts  
Acting Agent  
1500 City National Bank Tower, Oklahoma City,  
(Address) Oklahoma 73102

SUBSCRIBED AND SWORN TO before me this 27th day of August, 1973

My commission expires July 16, 1977

Mary W. [Signature]  
Notary Public.

DRILLERS LOG

WHARTON NO. 1

CASING RECORD:	OPERATOR:	Petroleum Reserve Corp.	DESCRIPTION:
8-5/8" @ 319'	CONTRACTOR:	Sage Drilling Co., Inc.	C NW/4
w/250 sax cement	COMMENCED:	January 10, 1973	Sec. 2-34S-8W
TOTAL DEPTH:	COMPLETED:	January 24, 1973	Harper County,
4700'			Kansas

<u>FORMATION</u>	<u>FROM</u>	<u>TO</u>	<u>REMARKS</u>
Surface Soil & Red Bed	0	322	
Shale	322	740	
Shale & Shells	740	1400	
Lime & Shale	1400	1675	
Shale & Lime	1675	1910	
Lime	1910	2068	
Lime & Shale	2068	2210	
Shale & Lime	2210	2925	
Lime & Shale	2925	3120	
Lime	3120	3340	
Shale & Lime	3340	3590	
Lime & Shale	3590	4110	
Lime	4110	4700	

4 1/2" set @ 4702'  
(log depth) w/150  
sax cement.

RECEIVED  
STATE CORPORATION COMMISSION  
AUG 16 1973  
CONSERVATION DIVISION  
Wichita, Kansas

I certify that this is a true and correct copy of the above log to the best of my knowledge.

SAGE DRILLING CO., INC.

By Clarence Michael  
Clarence Michael

Subscribed and sworn to before me this 23rd day of January, 1973.

Louise K. Whitted  
Louise K. Whitted, Notary Public



My commission expires:  
November 26, 1974.