

WELL PLUGGING RECORD

Give All Information Completely
Make Required Affidavit
Mail or Deliver Report to:
Conservation Division
State Corporation Commission
211 No. Broadway
Wichita, Kansas

Seward County, Sec. 32 Twp. 34 Rge. 34 (E) W (W)

Location as "NE/CNW/SW" or footage from lines C NW SE

Lease Owner W. J. Coppinger

Lease Name Courtney Well No. 1

Office Address 1207 Union National Bldg.

Character of Well (completed as Oil, Gas or Dry Hole) D & A

Date well completed Nov. 12 19 63

Application for plugging filed Dec. 13 19 63

Application for plugging approved Dec. 16 19 63


Plugging commenced Jan. 21 19 64

Plugging completed Jan. 24 19 64

Reason for abandonment of well or producing formation D & A

If a producing well is abandoned, date of last production -- 19 --

Was permission obtained from the Conservation Division or its agents before plugging was commenced? Yes

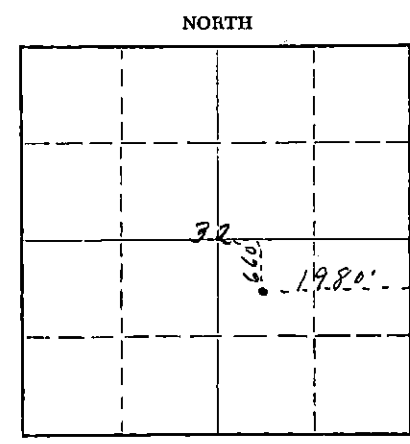

Locate well correctly on above Section Plat

Name of Conservation Agent who supervised plugging of this well Hugh Scott, Sublette, Kansas

Producing formation -- Depth to top -- Bottom -- Total Depth of Well -- Feet

Show depth and thickness of all water, oil and gas formations.

OIL, GAS OR WATER RECORDS

CASING RECORD

FORMATION	CONTENT	FROM	TO	SIZE	PUT IN	PULLED OUT
				8 5/8	1398	-0-
				4 1/2"	6735	2024

Describe in detail the manner in which the well was plugged, indicating where the mud fluid was placed and the method or methods used in introducing it into the hole. If cement or other plugs were used, state the character of same and depth placed, from 700' feet to 40' feet for each plug set.

Pulled casing out of well

Pulled 2024' of 4 1/2" casing; mud to 700'
set 35 sacks cement at 700'; mud to 40'
set 15 sacks cement 40' to surface.

RECEIVED
STATE CORPORATION COMMISSION

JAN 28 1964

CONSERVATION DIVISION
Wichita, Kansas

(If additional description is necessary, use BACK of this sheet)

Name of Plugging Contractor Forbes Casing Pulling, Inc.

Address Great Bend, Kansas

STATE OF Kansas, COUNTY OF Sedgwick, ss.

W. J. Coppinger (employee of owner) or (owner or operator) of the above-described well, being first duly sworn on oath, says: That I have knowledge of the facts, statements, and matters herein contained and the log of the above-described well as filed and that the same are true and correct. So help me God.

(Signature) WJC [Signature] 1207 Union National Building, Wichita, Kansas (Address)

SUBSCRIBED AND SWORN TO before me this 27th day of January, 19 64

My commission expires Dec. 22, 1964

Anne E. Winn

Notary Public.

25

Courtney #1
 C-W-SE Sec. 32-34S-34W
 Seward County, Kansas
 Company: W. J. Coppinger

Well commenced 10/20/63
 8-5/8" casing set @ 1398'
 Circulated w/ cement (700 sks.)
 4-1/2" casing set @ 6733'

FORMATION LOG

Top soil & sand	0-655
Sand & red bed	655-1026
Red bed & sand	1026-1400
Red bed & shale	1400-2155
Shale & anhydrite	2155-2561
Anhydrite & shale	2561-2633
Shale & lime	2633-2760
Lime & shale	2760-2966
Lime	2966-3259
Lime & shale	3259-3675
Shale & lime	3675-3810
Lime	3810-4394
Lime & shale	4394-4421
Lime	4421-5266
Lime & shale	5266-5360
Lime	5360-5484
Lime & shale	5484-5520
Shale w/lime streak	5520-5660
Shale & lime	5660-6044
Shale	6044-6155
Shale & lime	6155-6335
Lime & shale	6335-6509
Lime	6509-6588
Shale & lime	6588-6614
Lime & shale	6614-6658
Lime	6658-6735
	6735

T.D.

This is a true and exact copy of the formation, taken from
 The Daily Drilling Reports.

MAHONEY DRILLING COMPANY, INC.

F. W. Mahoney
 F. W. Mahoney, President

STATE OF KANSAS
 COUNTY OF SEWARD

Seen to before me this 15th day of November, 1963.

Walter Ottenton
 Notary Public

My Commission Expires, January 23, 1967