

STATE OF KANSAS
STATE CORPORATION COMMISSION


WELL PLUGGING RECORD

Give All Information Completely
Make Required Affidavit
Mail or Deliver Report to:
Conservation Division
State Corporation Commission
800 Bittling Building
Wichita, Kansas

Clark County, Sec. 6 Twp. 35-S Rge. (E) 25 (W)

Location as "NE/CNW/SW" or footage from lines NW SE
Lease Owner Ashland Oil & Refining Company
Lease Name Theis Well No. 1
Office Address 720 N.W. 50th - Oklahoma City
Character of Well (completed as Oil, Gas or Dry Hole) Gas
Date well completed October 14 19 61
Application for plugging filed December 1 19 66
Application for plugging approved December 5 19 66
Plugging commenced February 9 19 67
Plugging completed February 13 19 67
Reason for abandonment of well or producing formation Depleted

NORTH

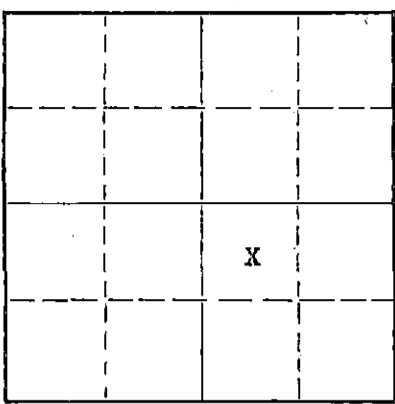

Locate well correctly on above Section Plat

If a producing well is abandoned, date of last production February 19 65
Was permission obtained from the Conservation Division or its agents before plugging was commenced? Yes

Name of Conservation Agent who supervised plugging of this well E. Eves
Producing formation Morrow Depth to top 5830 Bottom 5876 Total Depth of Well 6047 Feet
Show depth and thickness of all water, oil and gas formations.

OIL, GAS OR WATER RECORDS

CASING RECORD

FORMATION	CONTENT	FROM	TO	SIZE	PUT IN	PULLED OUT
				8 5/8	514	0
				4 1/2	6142.5	3995

Describe in detail the manner in which the well was plugged, indicating where the mud fluid was placed and the method or methods used in introducing it into the hole. If cement or other plugs were used, state the character of same and depth placed, from _____ feet to _____ feet for each plug set.

Pumped 15 sack cement plug to 4050'. Kept hole full of mud. Shot casing at 4020' & pulled 130 joints of 4 1/2" casing. Pumped 35 sack cement plug to 545' & capped well with 10 sacks cement.

RECEIVED
STATE CORPORATION COMMISSION
APR 5 1967
CONSERVATION DIVISION
Wichita, Kansas

(If additional description is necessary, use BACK of this sheet)
Name of Plugging Contractor Gayle E. Toland & Company
Address Box 94336 Oklahoma City, Oklahoma 73109

STATE OF Oklahoma COUNTY OF Oklahoma ss.
ASHLAND OIL & REFINING COMPANY (employee of owner) or (owner or operator) of the above-described well, being first duly sworn on oath, says: That I have knowledge of the facts, statements, and matters herein contained and the log of the above-described well as filed and that the same are true and correct. So help me God.
Robert H. Tompkins (Signature) Division Office Manager
Box 18695, Oklahoma City, Oklahoma 73118 (Address)

SUBSCRIBED AND SWORN TO before me this 3rd day of April 19 67
Donald R. Lunsford Notary Public.
My commission expires 1-11-70

15-225-10063-0000

COPY


WELL LOG BUREAU—KANSAS GEOLOGICAL SOCIETY
508 East Murdock, Wichita, Kansas

Company- ASHLAND OIL & REFINING CO.
Farm- Theis No. 1

SEC. 6 T. 35 R25W
C NW SE

Depth. 6215'
Date. 9-5-61 Comp. 10-1-61
Drilled or Treated.
Drill Contractor. Garvey Drilg. Co.
Logged. 1-6-62

County Clark
KANSAS

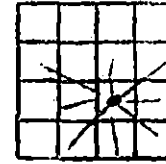

CASING:
8 5/8" 523' cem w/500 sx.
4 1/2" 6142.50' cem w/150 sx.

Elevation. 2115'
Production. 13,750,000 CFG

Figures Indicate Bottom of Formations.

surface clay	40
red bed	370
red bed & gyp	565
red bed	885
shale	1000
shale, sand & Anhydrite	1650
shale & shells	1800
shale	2100
lime & shale	2290
lime & chert	2516
lime & shale	2525
cherty lime & shale	2654
lime & chert	2776
lime & shale	2878
cherty lime & shale	2975
shale & lime	3104
lime & shale	3470
chalky lime & shale	3820
lime & shale	4818
chalky lime & shale	4090
lime	4924
lime & shale	5598
lime	5752
lime & shale	5845
shale & sand	5874
sand	5900
lime & shale	5980
lime	6065
lime & shale	6215
Total Depth	

TOPS: SCOUT	
Lansing	4620
Marmaton	5310
Morrow	5884
Chester	5954

RECEIVED
STATE CORPORATION COMMISSION

APR 10 1967

CONSERVATION DIVISION
Wichita, Kansas