


STATE OF KANSAS  
STATE CORPORATION COMMISSION  
CONSERVATION DIVISION  
P. O. BOX 17027  
WICHITA, KANSAS 67217

FORM CP-4

WELL PLUGGING RECORD

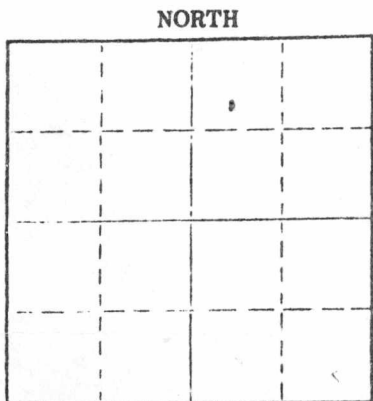

Locate well correctly on above Section Plat

Clark County, Sec. 6 Twp. 35 Rge. (E)25 (W)  
Location as "NE/CNWxSWx" or footage from lines 1320' FWL & 1320' FNL  
Lease Owner American Petrofina Co. of Texas  
Lease Name Thies Well No. B1-6  
Office Address 4613 Jacksboro Hwy. - Wichita Falls, TX  
Character of Well (completed as Oil, Gas or Dry Hole) dry hole  
Date well completed 7-6 1978  
Application for plugging filed 7-28 1978  
Application for plugging approved 7-31 1978  
Plugging commenced 8-8 1978  
Plugging completed 8-14 1978  
Reason for abandonment of well or producing formation dry hole

If a producing well is abandoned, date of last production 19  
Was permission obtained from the Conservation Division or its agents before plugging was commenced? yes

Name of Conservation Agent who supervised plugging of this well Clarence Thomas  
Producing formation \_\_\_\_\_ Depth to top \_\_\_\_\_ Bottom \_\_\_\_\_ Total Depth of Well 6223 Feet  
Show depth and thickness of all water, oil and gas formations.

OIL, GAS OR WATER RECORDS

CASING RECORD

FORMATION	CONTENT	FROM	TO	SIZE	PUT IN	PULLED OUT
				5 1/2"	6220'	2,809.57'
				8 5/8"	635'	None

Describe in detail the manner in which the well was plugged, indicating where the mud fluid was placed and the method or methods used in introducing it into the hole. If cement or other plugs were used, state the character of same and depth placed, from \_\_\_\_\_ feet to \_\_\_\_\_ feet for each plug set.

8-10-78. Set cast iron bridge plug at 5900'. with 25 sacks of cement on top.

8-12-78. Pumped 50 sacks of cement from 585'-685'.

8-14-78. Capped well with 10 sacks of cement from 4'-34', welded on steel plate with name and date.

8-8-78. Pumped 35 sacks of cement out perforations @ 5974'-74'

(If additional description is necessary, use BACK of this sheet)

Name of Plugging Contractor Lillard Casing Pulling, Inc.  
Address P. O. Box 962 - Woodward, OK 73801

STATE OF Oklahoma COUNTY OF Woodward ss.  
James Lester (employee of owner) or (owner or operator) of the above-described

well, being first duly sworn on oath, says: That I have knowledge of the facts, statements, and matters herein contained and the log of the above-described well as filed and that the same are true and correct. So help me God.

(Signature) James Lester  
Box 121 Cyril Okla. (Address)

SUBSCRIBED AND SWORN TO before me this 23rd day of August 1978

My commission expires 3-24-81 Notary Public.

RECEIVED  
STATE CORPORATION COMMISSION

AUG 25 1978

CONSERVATION DIVISION  
Wichita, Kansas

DRILLERS LOG

THEIS "B" NO. 1-6


CASING RECORD:	OPERATOR: American Petrofina Company of Texas	DESCRIPTION:
8-5/8" set @ 640' w/300 sax cement	CONTRACTOR: Sage Drilling Co., Inc.	1320' FNL & 1320' FWL
TOTAL DEPTH: 6220'	COMMENCED: May 23, 1978	Sec. 6-35S-25W Clark County, Kansas.
	COMPLETED: June 8, 1978	

<u>FORMATION</u>	<u>FROM</u>	<u>TO</u>	<u>REMARKS</u>
Surface Soil & Red Bed	0	475	
Red Bed	475	640	
Red Bed & Shale	640	2160	
Anhydrite & Shale	2160	2635	
Lime & Shale	2635	2845	
Dolomite & Shale	2845	3065	
Lime & Shale	3065	3950	
Shale & Lime	3950	4360	
Lime & Shale	4360	5818	
Shale & Lime	5818	5928	
Lime & Shale	5928	6008	Ran DST#1 @ 6008'
Lime & Shale	6008	6080	Ran DST#2 @ 6080'
Lime & Shale	6080	6220	Logged Hole, Ran DST#3, 5 1/2" set @ 6218' w/200 sax Pozmix

I certify that this is a true and correct copy of the log on the above captioned well to the best of my knowledge.

SAGE DRILLING CO., INC.

By John R. Bartholomew  
John R. Bartholomew

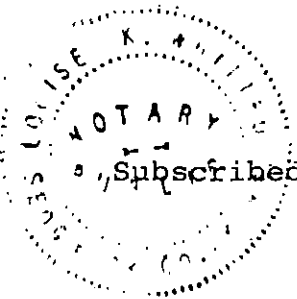

Subscribed and sworn to before me this 20th day of June, 1978.

Louise K. Whitted  
Louise K. Whitted - Notary Public

My commission expires:  
November 26, 1978.

RECEIVED  
STATE CORPORATION COMMISSION  
JUL 31 1978  
CONSERVATION DIVISION  
Wichita, Kansas