

STATE OF KANSAS
STATE CORPORATION COMMISSION


Form CP-4

WELL PLUGGING RECORD

Give All Information Completely
Make Required Affidavit
Mail or Deliver Report to:
Conservation Division
State Corporation Commission
211 No. Broadway
Wichita, Kansas

Seward County, Sec. 33 Twp. 34 Rge. 34W (E) (W)

Location as "NE/CNW/SE/SW" or footage from lines SW SW
Lease Owner Malonee - Coppinger Operations Inc.
Lease Name Keating Well No. 1
Office Address 1207 Union National Bldg. Wichita
Character of Well (completed as Oil, Gas or Dry Hole) D & A
Date well completed _____ 19____
Application for plugging filed 4-7 1966
Application for plugging approved 4-11- 1966
Plugging commenced 4-16 1966
Plugging completed 4-21 1966
Reason for abandonment of well or producing formation Dry Hole

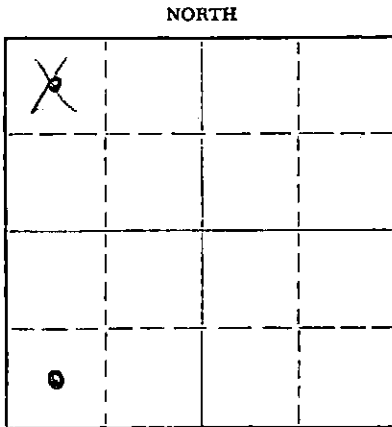

Locate well correctly on above Section Plat

If a producing well is abandoned, date of last production _____ 19____
Was permission obtained from the Conservation Division or its agents before plugging was commenced? Yes

Name of Conservation Agent who supervised plugging of this well Edd Eaves
Producing formation Perfs. 4380 To 87 Depth to top _____ Bottom _____ Total Depth of Well 6650' Feet
Show depth and thickness of all water, oil and gas formations.

OIL, GAS OR WATER RECORDS

CASING RECORD

FORMATION	CONTENT	FROM	TO	SIZE	PUT IN	PULLED OUT
				8 5/8	1366'	0
				4 1/2	4488'	
				4 1/2	4488'	3516'

Describe in detail the manner in which the well was plugged, indicating where the mud fluid was placed and the method or methods used in introducing it into the hole. If cement or other plugs were used, state the character of same and depth placed, from _____ feet to _____ feet for each plug set.

Mix 20 sacks cement to plug off perforrations at 4380'. Stop plug at 4200'. Shoot pipe loose at 3516. Pull 4 1/2" casing to 700' and pump 35 sacks cement at 700' to 600'. Lay down casing and put 15 sacks cement at 45' to 0 feet. Cut off 8 5/8" casing 3 feet below ground and weld on cap.

RECEIVED
STATE CORPORATION COMMISSION

MAY 3 - 1966

CONSERVATION DIVISION
Wichita, Kansas

(If additional description is necessary, use BACK of this sheet)

Name of Plugging Contractor Sargent's Casing Pulling Service
Address Box 506 Liberal, Kansas

STATE OF KANSAS COUNTY OF SEDGWICK, ss.
F. W. Mallonee

(owner or operator) of the above-described well, being first duly sworn on oath, says: That I have knowledge of the facts, statements, and matters herein contained and the log of the above-described well as filed and that the same are true and correct. So help me God.

(Signature) F. W. Mallonee
1207 Union National Bldg., Wichita, Ks.
(Address)

SUBSCRIBED AND SWORN TO before me this Second day of May, 19 66

My commission expires April 23, 1968

Leola Lynskey
Notary Public.

Mallonee-Coppinger Operations, Inc.

Keating # 1
Section 33-34S-34W CSW SW
Seward County, Kansas

Set 1365' KB 8-5/8" Csg. 750 Sx Cement
Cement Circulate
Set 4488' K.B. 4-1/2 Csg. 150 SX Cement

Sand & Gyp	0-545
Sand & Red Bed	545-1366
Red Bed	1366-1429
Red Bed & Anhydrite	1429-2010
Shale ;& Anhydrite	2010-2548
Lime & Shale	2548-3839
Lime	3839-4002
Lime & Shale	4002-4441
Lime	4441-5453
Lime & Shale	5453-5614
Shale	5614-6131
Shale & Lime	6131-6257
Shale	6257-6400
Shale & Lime	6400-6465
Lime	6465-6515
Lime & Chert	6515-6564
Lime	6564-6650
TD	6650

RECEIVED
STATE CORPORATION COMMISSION
APR 14 1966
CONSERVATION DIVISION
Wichita, Kansas

This a copy of the Formation taken from the Daily Drilling Reports.

T. W. Mahoney
T. W. MAHONEY, PRESIDENT

STATE OF KANSAS
COUNTY OF SEWARD

Sworn to before me this 1 Day of April 1, 1966

George W. Carnahan, Jr.
George W. Carnahan, Jr.
Notary Public

My Commission Expires January 24, 1968