


15-199-20094-0000

STATE OF KANSAS  
STATE CORPORATION COMMISSION

Form CP-4

Give All Information Completely  
Make Required Affidavit  
Mail or Deliver Report to:  
Conservation Division  
State Corporation Commission  
212 No. Market  
Wichita, Kansas

WELL PLUGGING RECORD

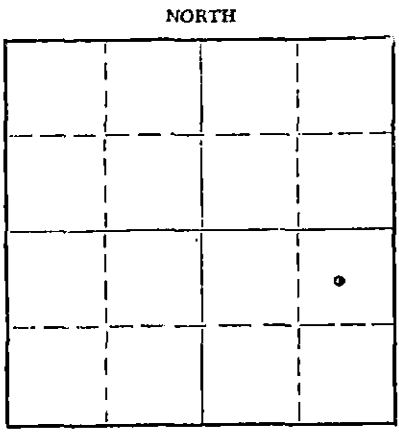

Locate well correctly on above  
Section Plat

Morton County, Sec. 3 Twp. 33S Rge. 41 (E) (W)  
Location as "NE/CNW/SW" or footage from lines 660' FEL & 1980' FSL  
Lease Owner Anadarko Production Company  
Lease Name Davis "A" Well No. 2  
Office Address Box 351 Liberal, Kansas 67901  
Character of Well (completed as Oil, Gas or Dry Hole) Dry Hole  
Date well completed 9/11 1972  
Application for plugging filed 9/18 1972  
Application for plugging approved Verbal Approval 9/11 1972  
Plugging commenced 9/11 1972  
Plugging completed 9/12 1972  
Reason for abandonment of well or producing formation

If a producing well is abandoned, date of last production 19  
Was permission obtained from the Conservation Division or its agents before plugging was commenced? Yes  
Name of Conservation Agent who supervised plugging of this well Mr. Ed Eves Box "F" Sublette, Kansas 67877  
Producing formation Depth to top Bottom Total Depth of Well 5160 Feet  
Show depth and thickness of all water, oil and gas formations.

OIL, GAS OR WATER RECORDS

CASING RECORD


| FORMATION | CONTENT | FROM | TO | SIZE  | PUT IN | PULLED OUT |
|-----------|---------|------|----|-------|--------|------------|
|           |         |      |    | 8 5/8 | 1539'  | NONE       |
|           |         |      |    |       |        |            |
|           |         |      |    |       |        |            |
Describe in detail the manner in which the well was plugged, indicating where the mud fluid was placed and the method or methods used in introducing it into the hole. If cement or other plugs were used, state the character of same and depth placed, from feet to feet for each plug set.

Spotted 75 sx. cement 1600' to 1400'.  
Spotted 35 sx. cement 1200' to 1100'.  
Spotted 15 sx. cement 45' to surface.

RECEIVED  
STATE CORPORATION COMMISSION  
SEP 25 1972  
CONSERVATION DIVISION  
Wichita, Kansas

(If additional description is necessary, use BACK of this sheet)  
Name of Plugging Contractor Lohmann-Johnson Drilling Company  
Address Oklahoma City, Oklahoma

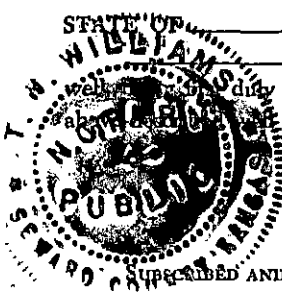

KANSAS, COUNTY OF SEWARD, ss.  
W. A. BEATTY (employee of owner) or (owner or operator) of the above-described well, duly sworn on oath, says: That I have knowledge of the facts, statements, and matters herein contained and the log of the well as filed and that the same are true and correct. So help me God.

(Signature) W. A. Beatty  
W. A. Beatty Division Prod. Manager  
Box 351 Liberal, Kansas 67901 (Address)

Subscribed and sworn to before me this 20th day of September, 1972

My Commission Expires April 28, 1975

My commission expires

T. W. Williams  
Notary Public.

CONFIDENTIAL











15-129-20094-0000

DRILLER'S LOG

WELL NAME Davis "A" #2 COMPANY OPERATING Anadarko Production Company  
 ADDRESS OF COMPANY Box 351 Liberal, Kansas 67901  
 WELL LOCATION 1/4 NE 1/4 SE 1/4  
1980 Ft. North of South Line,  
4650 Ft. East of West Line, Sec. 3, Twp. 33S, Rge. 41W, Morton County, Kansas  
 DRILLING STARTED 8/31, 19 72, DRILLING COMPLETED 9/11, 19 72  
 WELL COMPLETED \_\_\_\_\_, 19 \_\_\_\_\_, WELL CONNECTED \_\_\_\_\_, 19 \_\_\_\_\_  
 ELEVATION 3441.1 Ft. Ground Level CHARACTER of WELL (Oil, Gas, Dry Hole) Dry Hole

| OIL OR GAS SANDS OR ZONES - PERFORATIONS - ACIDIZING AND FRACTURING INFORMATION |      |    |              |              |           |
|---|------|----|--------------|--------------|-----------|
| Name  | From | To | No. of Shots | Gallons Used | Kind Used |
|   |      |    |              |              |           |
|   |      |    |              |              |           |
RECEIVED  
 STATE CORPORATION COMMISSION  
 SEP 25 1972  
 CONSERVATION DIVISION  
 Wichita, Kansas

CASING RECORD

| Size  | Amount Set | Sacks of Cement | Amount Pilled |
|-------|------------|-----------------|---------------|
| 8 5/8 | 1539'      | 700             | NONE          |
|       |            |                 |               |
|       |            |                 |               |
|       |            |                 |               |

FORMATION RECORD

| Formation           | Top  | Bottom | Formation | Top | Bottom |
|---------------------|------|--------|-----------|-----|--------|
| Surface Sand & Clay | 0    | 820    |           |     |        |
| Red Bed & Lime      | 820  | 1110   |           |     |        |
| Sand                | 1110 | 1275   |           |     |        |
| Red Bed             | 1275 | 1340   |           |     |        |
| Anhydrite           | 1340 | 1540   |           |     |        |
| Shale               | 1540 | 1860   |           |     |        |
| Red Bed & Lime      | 1860 | 2494   |           |     |        |
| Shale & Lime        | 2494 | 2705   |           |     |        |
| Lime                | 2705 | 5160   |           |     |        |
| TOTAL DEPTH         | 5160 |        |           |     |        |
|                     |      |        |           |     |        |
|                     |      |        |           |     |        |
|                     |      |        |           |     |        |

RESULTS OF INITIAL PRODUCTION TEST: D & A