


STATE OF KANSAS
STATE CORPORATION COMMISSION
CONSERVATION DIVISION
WICHITA, KANSAS

FORM CP-4

WELL PLUGGING RECORD

New Address
245 North Water
Wichita, Kansas 67202

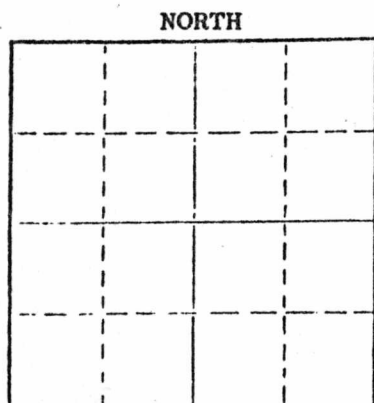

Harper County, Sec. 2 Twp. 34S Rge. 9W (E) (W)

Location as "NE/CNW/SW" or footage from lines C E/2 SW
Lease Owner PICKRELL DRILLING COMPANY
Lease Name HEWITT "B"
Office Address 205 LITWIN BLDG., WICHITA, KS. 67202 Well No. 1
Character of Well (completed as Oil, Gas or Dry Hole) Dry Hole
Date well completed 8-14-76 19
Application for plugging filed 8-14-76 19
Application for plugging approved 8-14-76 19
Plugging commenced 8-14-76 19
Plugging completed 8-14-76 19
Reason for abandonment of well or producing formation Dry Hole

If a producing well is abandoned, date of last production 19
Was permission obtained from the Conservation Division or its agents before plugging was commenced? Yes

Name of Conservation Agent who supervised plugging of this well G. R. Biberstein
Producing formation _____ Depth to top _____ Bottom _____ Total Depth of Well 4600 Feet
Show depth and thickness of all water, oil and gas formations.

OIL, GAS OR WATER RECORDS

CASING RECORD

FORMATION	CONTENT	FROM	TO	SIZE	PUT IN	PULLED OUT
				8 5/8	209	None

Describe in detail the manner in which the well was plugged, indicating where the mud fluid was placed and the method or methods used in introducing it into the hole. If cement or other plugs were used, state the character of same and depth placed, from _____ feet to _____ feet for each plug set.

35 sacks at 200'
15 sacks at 40'
5 sacks in Rat Hole Comp. at 11PM 8-14-76

RECEIVED
STATE CORPORATION COMMISSION
SEP 09 1976
CONSERVATION DIVISION
WICHITA, KANSAS

Name of Plugging Contractor PICKRELL DRILLING COMPANY (If additional description is necessary, use BACK of this sheet)
Address 205 LITWIN BLDG., WICHITA, KS. 67202

STATE OF Kansas COUNTY OF Sedgwick
C. W. Sebitts (employee of owner) or (owner or operator) of the above-described

well, being first duly sworn on oath, says: That I have knowledge of the facts, statements and matters herein contained and the log of the above-described well as filed and that the same are true and correct. So help me God.

(Signature) C. W. Sebitts
205 Litwin Bldg., Wichita, Ks. 67202 (Address)

Subscribed and sworn to before me this 26 day of August 19 76

My commission expires _____
Jo Ann Sarver Notary Public.



ROTARY DRILLING LOG

COMPANY: PICKRELL DRILLING COMPANY
205 LITWIN BLDG.
WICHITA, KANSAS 67202
LOCATION: HEWITT "B" #1
C E/2 SW 2-34S-9W
HARPER CO., KANSAS
CONTRACTOR: **PICKRELL DRILLING COMPANY**
Wichita, Kansas

Rotary Drilling Commenced 8-3-76
Rotary Drilling Completed 8-14-76

CASING RECORD: Surface casing of 8 5/8" set at 209' cement with 175 sacks.

LOG

(Figures indicate bottom of formation — measurements from top of rotary bushing.)

Sand	45
Red Rock & Shale	130
Red Bed	210
Red Bed	640
Shale	1415
Shale & Lime	1599
Lime & Shale	1714
Lime & Shale	1830
Shale & Lime	1965
Shale & Lime	2032
Lime & Shale	2145
Shale & Lime	2290
Lime & Shale	2366
Shale & Lime	2485
Shale	2655
Shale	2775
Shale & Lime	2895
Lime & Shale	3040
Lime & Shale	3166
Lime & Shale	3260
Shale & Lime	3415
Lime & Shale	3592
Shale & Lime	3700
Shale & Lime	3900
Shale & Lime	4005
Shale & Lime	4130
Lime & Shale	4215
Lime & Shale	4296
Lime & Shale	4350
Lime	4405
Lime & Shale	4468
Lime & Shale	4515
Shale & Lime	4578
Shale & Lime	4600

RECEIVED
STATE CORPORATION COMMISSION
SEP 09 1976
CONSERVATION DIVISION
Wichita, Kansas

The undersigned, C. W. Sebitts, Attorney-in-Fact for PICKRELL DRILLING COMPANY, hereby certifies in behalf of said Company, that the above is a true and correct log of the formation encountered in drilling the above well as reflected by the Daily Drilling Reports.

PICKRELL DRILLING COMPANY
By [Signature]
Attorney-in-Fact
C. W. Sebitts

STATE OF KANSAS }
COUNTY OF SEDGWICK } ss.:

On this 26 day of August, 1976, before me the undersigned, a Notary Public, in and for the County and State aforesaid, personally appeared C. W. Sebitts, to me known to be the identical person who subscribed the name of PICKRELL DRILLING COMPANY to the foregoing instrument as its Attorney-in-Fact and acknowledged to me that he executed the same as his free and voluntary act and deed, and as the free and voluntary act and deed of such company, for the uses and purposes therein set forth.

Given under my hand and seal of office the day and year last above written.

My commission expires:



[Signature]
Notary Public
Jo Ann Sarver