


STATE OF KANSAS
STATE CORPORATION COMMISSION

Form CP-4

Give All Information Completely
Make Required Affidavit
Mail or Deliver Report to:
Conservation Division
State Corporation Commission
P. O. Box 17027

WELL PLUGGING RECORD

Wichita, Kansas 67217
NORTH

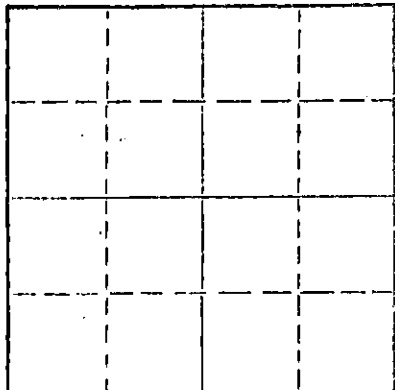

Locate well correctly on above
Section Plat

Meade County, Sec. 19 Twp. 34 Rge. (E) 29 (W)
Location as "NE/CNW&SW" or footage from lines C SW SW
Lease Owner Brooks Hall Oil Corporation
Lease Name Adams Ranch Well No. 1
Office Address 1704 City Nat'l Bank Tower, Okla. City
Character of Well (completed as Oil, Gas or Dry Hole) Dry Hole
Date well completed February 27, 1973
Application for plugging filed 19
Application for plugging approved 19
Plugging commenced February 27, 1973
Plugging completed February 27, 1973
Reason for abandonment of well or producing formation Dry Hole

If a producing well is abandoned, date of last production 19
Was permission obtained from the Conservation Division or its agents before plugging was commenced? Yes (Edgar Eves of Sublette)

Name of Conservation Agent who supervised plugging of this well
Producing formation Depth to top Bottom Total Depth of Well 6000 Feet
Show depth and thickness of all water, oil and gas formations.

OIL, GAS OR WATER RECORDS

CASING RECORD

| FORMATION | CONTENT | FROM | TO | SIZE | PUT IN | PULLED OUT |
|-----------|----------------|------|-------|--------|--------|------------|
| | Surface Casing | 0 | 1465' | 8-5/8" | 1465' | None |
| | | | | | | |
| | | | | | | |
Describe in detail the manner in which the well was plugged, indicating where the mud fluid was placed and the method or methods used in introducing it into the hole. If cement or other plugs were used, state the character of same and depth placed, from feet to feet for each plug set.

Heavy Mud from Total Depth to 1000 Feet,
35 sax Cement; Mud to 45 Feet, 1/2 sax Halls,
Plug and 15 sax Cement to Base of Cellar;
2 sax Cement in Rat Hole. Job Completed
@ 11 P.M.


(If additional description is necessary, use BACK of this sheet)

Name of Plugging Contractor Halliburton
Address Box 129, Liberal, Kansas 67901

STATE OF KANSAS COUNTY OF SEDGWICK
Clarence Michael of Sage Drilling Co. (operator of well) or (owner or operator) of the above described well being first duly sworn on oath, says: That I have knowledge of the facts, statements, and matters herein contained and the log of the above described well as filed and that the same are true and correct. So help me God.

(Signature) Clarence Michael
500 Bitting Building, Wichita, Kansas
(Address)

Subscribed and sworn to before me this 28th day of February, 1973.
Louise K. Whitted, Notary Public.

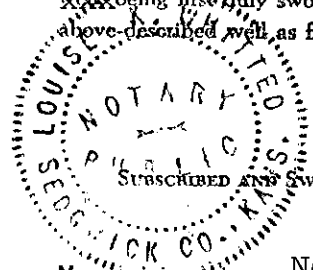

DRILLERS LOGADAMS RANCH NO. 1

| | | | |
|------------------|-------------|-----------------------|-----------------|
| CASING RECORD: | OPERATOR: | Brooks Hall Oil Corp. | DESCRIPTION: |
| 8-5/8" @ 1465' | CONTRACTOR: | Sage Drilling Co. | C SW SW |
| w/700 sax cement | COMMENCED: | February 14, 1973 | Sec. 19-34S-29W |
| TOTAL DEPTH: | COMPLETED: | February 27, 1973 | Meade County, |
| 6000' | | | Kansas |

| <u>FORMATION</u> | <u>FROM</u> | <u>TO</u> | <u>REMARKS</u> |
|---------------------|-------------|-----------|----------------|
| Surface Sand & Clay | 0 | 325 | |
| Clay & Sand | 325 | 525 | |
| Red Bed & Gyp | 525 | 950 | |
| Sand & Shale | 950 | 1245 | |
| Shale & Anhydrite | 1245 | 1500 | |
| Shale | 1500 | 2562 | |
| Lime | 2562 | 2948 | |
| Lime & Shale | 2948 | 4230 | |
| Shale & Lime | 4230 | 4613 | |
| Lime & Shale | 4613 | 6000 | D&A |

I certify that this is a true and correct copy of the above log to the best of my knowledge.

SAGE DRILLING CO., INC.

By Clarence Michael
Clarence Michael

Subscribed and sworn to before me this 28th day of February, 1973.

Louise K. Whitted
Louise K. Whitted - Notary Public

My commission expires:
November 26, 1974.

