

WELL PLUGGING RECORD

Give All Information Completely  
Make Required Affidavit  
Mail or Deliver Report to:  
Conservation Division  
State Corporation Commission  
211 No. Broadway  
Wichita, Kansas

Meade County, Sec. 18 Twp. 34S Rge. 29W (E) (W)

Location as "NE/CNW/SW" or footage from lines Ctr NE SW

Lease Owner Texaco Inc.

Lease Name H. G. Adams "C" Well No. 1

Office Address 614 Bitting Bldg., Wichita, Kansas

Character of Well (completed as Oil, Gas or Dry Hole) Gas

Date well completed 12-10 19 59

Application for plugging filed 4-18 19 62

Application for plugging approved Verbal Approval 4-18 19 62


Plugging commenced 4-21 19 62

Plugging completed 4-23 19 62

Reason for abandonment of well or producing formation dry hole

If a producing well is abandoned, date of last production dry hole 19

Was permission obtained from the Conservation Division or its agents before plugging was commenced? yes

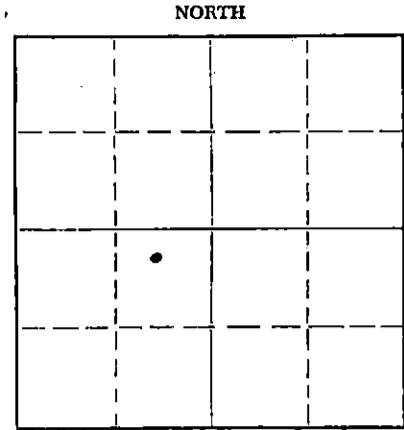

Locate well correctly on above Section Plat

Name of Conservation Agent who supervised plugging of this well V. F. Simoncic

Producing formation Depth to top Bottom Total Depth of Well 6015 Feet

Show depth and thickness of all water, oil and gas formations. PBD 3317

OIL, GAS OR WATER RECORDS

CASING RECORD

FORMATION	CONTENT	FROM	TO	SIZE	PUT IN	PULLED OUT
				18"	40	0
				8-5/8"	1638	0
				5-1/2"	4525	2953

Describe in detail the manner in which the well was plugged, indicating where the mud fluid was placed and the method or methods used in introducing it into the hole. If cement or other plugs were used, state the character of same and depth placed, from feet to feet for each plug set.

Hole plugged as follows: Sand 3317-3205, 5 sx cement 3205-3200; mud 3200-1200, 20 sx cement 1200-1185 void 1185-30, rock bridge & 10 sx cement 30-3'.

RECEIVED  
STATE CORPORATION COMMISSION  
4-25-62  
APR 25 1962

CONSERVATION DIVISION  
Wichita, Kansas

(If additional description is necessary, use BACK of this sheet)

Name of Plugging Contractor Knight Casing Pulling Company

Address Box 304, Chase, Kansas

STATE OF Kansas COUNTY OF Sedgwick, ss.

M. C. Harrell (employee of owner) or (owner/contractor) of the above-described

well, being first duly sworn on oath, says: That I have knowledge of the facts, statements, and matters herein contained and the log of the above-described well as filed and that the same are true and correct. So help me God.

(Signature) M. C. Harrell

614 Bitting Bldg., Wichita, Kansas

(Address)

SUBSCRIBED AND SWORN to before me this 24th day of April, 1962

My commission expires June 20-1964

Notary Public.



*File* 15-119-10318-0000

**TEXACO INC.—LOG OF WELL**

Tulsa DIVISION

640 ACRES  
N


INDICATE EXACT WELL LOCATION & LEASE BOUNDARY WITHIN SECTION

WELL H. G. Adams "C" #1 L. D. FILE NO. 121771

LOC. Ctr. NE SW 18 34S 29W

Staked 3300' S & 1980' E of NW Corner

DIST. Wichita CO.-PARISH Neade STATE Kansas

COMM. DRLG. 11-3-59 COMP. DRLG. 11-28-59 DAYS DRLG. 26

ROT. FROM 0 TO 6015 CABLE FROM - TO PB-3317

CONTR. OR CO. RIG NO. Stickle Drig. Co. T. D. DRILLED 6015

COMP. T. D. PB 3317 ZERO ELEV. 2579 GRD. ELEV. 2579 CBG. FLG. ELEV. KB-GL 10'  
GL-BH 0'

DATE OF FIRST PROD. Dry OFFICIAL COMP. DATE 12-10-59

LOGS RUN Radiation Guard Log

**CASING RECORD**

SIZE INCHES	DEPTH FEET	WEIGHT #/FT.	GRADE	RANGE	REMARKS—QUAN. CMT., TEMP. SURV., ETC.
18"	40	SW		3	Set & Cemented @ 43' w/7 yds. Concrete.
8-5/8"	1638	24#	J	2	Set & Cemented @ 1637' w/350 Sacks Cement Circ.
5-1/2"	4525	14#	SH	2	Set & Cemented @ 4525' w/250 Sacks Top of Cement 3620'.
<u>CENTRALIZERS:</u>		4475, 3390 & 3250'			
<u>SCRATCHERS:</u>		4490, 4470, 3370, 3350, 3230 & 3210.			

*cc: to Tulsa  
K.W. Log  
Field*

**COMPLETION DATA**

FORMATION	<u>Dry Hole</u>				
DATE OF TEST					
DEPTH OF PROD. INTERVAL					
INITIAL PRODUCTION:		OIL - BPD			
		GAS - MCF			
		WATER - BPD			
		GOR			
		BHP - PSI			
CORRECTED API GRAVITY					
PRODUCING CONDITIONS					
ARTIFICIAL STIMULATION					

**RECEIVED**  
STATE CORPORATION COMMISSION  
APR 20 1962  
CONSERVATION DIVISION  
Wichita, Kansas

**REMARKS**

*D 4.25  
2) \$720.00  
680.00  
\$480.00*

WELL H. G. Adams "C" #1 FIELD Adams Ranch AREA Liberal