


STATE OF KANSAS
STATE CORPORATION COMMISSION

WELL PLUGGING RECORD

Give All Information Completely
Make Required Affidavit
Mail or Deliver Report to
Conservation Division
State Corporation Comm.
245 North Water
Wichita, KS 67202

Location as Meade County. Sec. 17 Twp. 34 Rge. 29 E/W
"NE/CNW $\frac{1}{4}$ SW $\frac{1}{4}$ " or footage from lines
C NE/4 SE/4

Lease Owner Calvin Exploration Inc.
Lease Name Nolting Well No. 1-17
Office Address Englewood, Colorado 80111
Character of Well (Completed as Oil, Gas or Dry Hole)
Gas
Date Well completed _____ 19____
Application for plugging filed 4-9 1980
Application for plugging approved 4-10 1980
Plugging commenced 4-14 1980
Plugging completed 4-16 1980

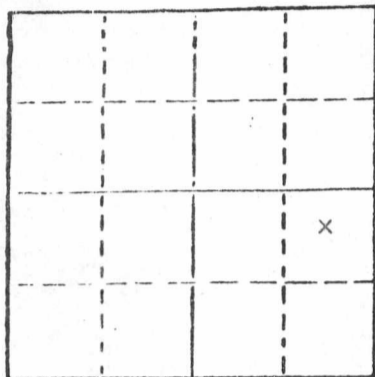

Locate well correctly on above
Section Plat

Reason for abandonment of well or producing formation
Non Comercial value
If a producing well is abandoned, date of last production
None 19____
Was permission obtained from the Conservation Division or
its agents before plugging was commenced?

Name of Conservation Agent who supervised plugging of this well Mr. Thomas
Producing formation Chase Depth to top 3140' Bottom 3142' Total Depth of Well 6470'
Show depth and thickness of all water, oil and gas formations.


OIL, GAS OR WATER RECORDS

CASING RECORD

FORMATION	CONTENT	FROM	TO	SIZE	PUT IN	PULLED OUT
Surface				8 5/8"	1520'	0'
Production				4 1/2"	6315'	2543'

Describe in detail the manner in which the well was plugged, indicating where the mud fluid was placed and the method or methods used in introducing it into the hold. If cement or other plugs were used, state the character of same and depth placed, from _____ feet to _____ feet for each plug set.

Pump 1 sack of hulls & 10 sacks cement to 3020' Pressured to 1700lbs.
Pumped 35 sacks cement 1450' to 1550'
Displaced to 750'
Pumped 25 sacks cement 750' to 650'
Displaced to 40'
Put bridge & 10 sacks cement 40' to 0'
Cut off 8 5/8" 3' below ground level.

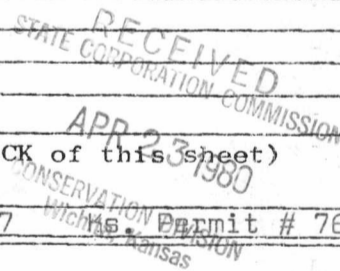

(If additional description is necessary, use BACK of this sheet)

Name of Plugging Contractor Midwest Casing Pulling
Box F, Sublette, Kansas 67877

STATE OF KANSAS COUNTY OF HASKELL, ss.
I Edgar J. Eves (employee of owner) or (owner or operator)
of the above-described well, being first duly sworn on oath, says: That I have knowledge of the facts, statements, and matters herein contained and the log of the above-described well as filed and that the same are true and correct. So help me God.

(Signature) Edgar J. Eves
Box F, Sublette, Kansas 67877
(Address)

SUBSCRIBED AND SWORN TO before me this 18th day of April, 1980

Sondra L Eves
Notary Public.

My commission expires 12-6-80

